


Map No. Kansas Sec. 16 Twp. 23 R. 9E
 Well No. 2 Noble Farm
Greenland Oil Co. Company

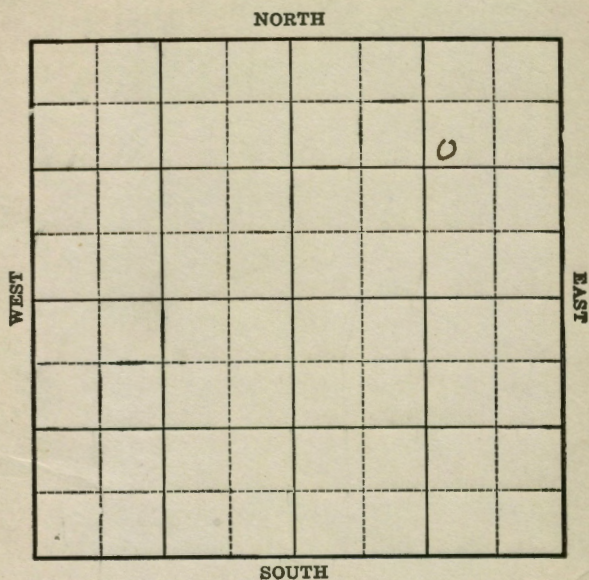

Location _____
 Drilling Remarks:

Rig Up _____
 Drilling Remarks:


RECORD

Cased _____ in. _____ ft.
 Sand _____
 Gas _____
 Oil _____
 Total Depth _____

PRODUCTION

1st 24 hrs. Nat. _____
 1st 24 hrs. after shot _____
 Gas _____ cu. ft.
 Dry Hole _____
 Abandoned _____

Map No. Kansas Sec. 16 Twp. 23 R. 9E
 Well No. 2 Noble Farm
Greenland Oil Company

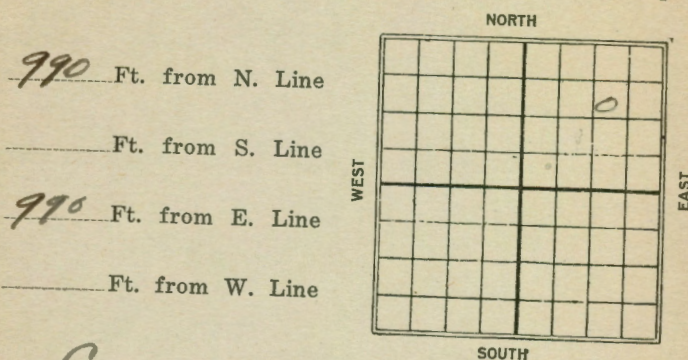

990 Ft. from N. Line

_____ Ft. from S. Line

990 Ft. from E. Line

_____ Ft. from W. Line

Date

1925

REPORT

4/17 Timbers
5/29 Sly 2012
6/5 F 2448 1st Oil 2450
Pay 2456-84 Sly 2490
in shale Only small
sho 0+2
6/12 2448-2504- T.D. 2504-0 2450
100/75 lbo.

Map No. 135400 Sec. 16 Twp. 23 R. 9Well No. 2 7060Greenland oil & c. Company

Contractor

SECTION PLAT

990 Ft. from N. Line

Ft. from S. Line

990 Ft. from E. Line

Ft. from W. Line

COMPLETED

Location

Rig up

Drilling and Remarks:

1st oil 2450'100/75 b/s

RECORD

Cased _____ in., _____ ft.

Sand 2448-2504

Gas _____

Oil _____

Total Depth 2504

PRODUCTION

1st 24 hrs. Nat. _____

1st 24 hrs. after shot _____

Gas _____ Cu. Ft.

Dry Hole _____

Abandoned _____

Date

JUN 12 1925

CHAS. L. SHERWOOD

192

Scout

Map No. 135400 Sec. 16 Twp. 23 R. 9^EWell No. 2 7060Greenland oil & c. Company

Contractor

FIRST REPORTS

SECTION PLAT

990 Ft. from N. Line

Ft. from S. Line

990 Ft. from E. Line

Ft. from W. Line

Location

Rig up

Drilling and Remarks:

Timber

RECORD

Cased _____ in., _____ ft.

Sand _____

Gas _____

Oil _____

Total Depth _____

PRODUCTION

1st 24 hrs. Nat. _____

1st 24 hrs. after shot _____

Gas _____ Cu. Ft.

Dry Hole _____

Abandoned _____

Date

APR 17 1925

192

Chas. L. Sherwood

Scout