


Greenwood

KANSAS

SECTION 16 TOWNSHIP 23 RANGE 9E

WELL NO. #1 Noller "B"

COMPANY Barnard Petroleum

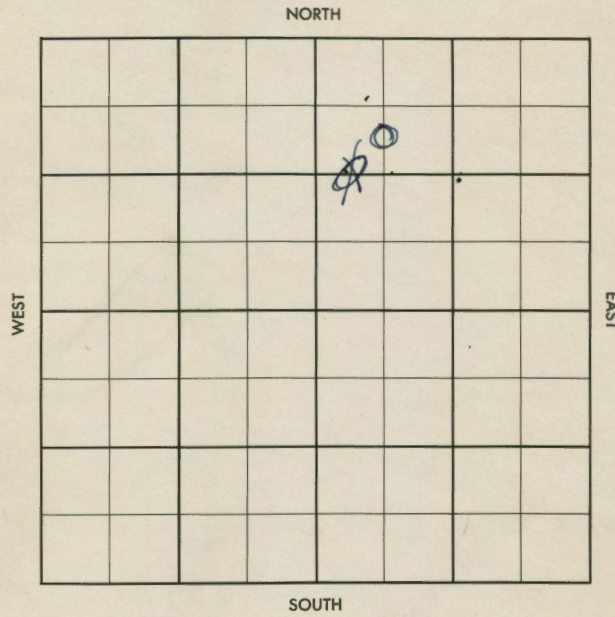

FORM 513 SUNRAY

County Greenwood Elev. _____
 Sec. 16 Twp. 23 Rge. 9E
 Company Barnard Petroleum
 FarmName Noller "B" No. 1

TOPS	DEPTH	LOG	DATUM	Loc. in Sec.
Anh.				<u>C W 1/2 W 1/2 NE</u>
Tr.				
H.				
Tr.				
Dg.				
Bl.				
L.				
K.C.				Geol. _____
B.K.C.				Contr. _____
Ce.				
C.				
M.				Pool _____
M.				<u>Teeter</u>
K.				
Mz.				
Me.				
V.				
S.				
S.				
A.				
R.				
Pe.				
G.				

Date Comm.

RUR

FORM 513 SUNRAY

County Greenwood Elev. 1593 RB
 Sec. 16 Twp. 23 Rge. 9E
 Company Barnard Petroleum
 FarmName Noller "B" No. 1

TOPS	DEPTH	LOG	DATUM	Loc. in Sec.
Anh.				<u>C W 1/2 W 1/2 NE</u>

Date Comm.

RUR DEC 19 56 12-13-56

1600 DEC 26 56 878 106

DEA. (H) JAN 2 '57