


Map No. K Sec. 16 Twp. 23 R. 9Well No. 15 Teeter Farm _____Empire Company1170 Ft. from N. Line

_____ Ft. from S. Line

200 Ft. from E. Line

_____ Ft. from W. Line

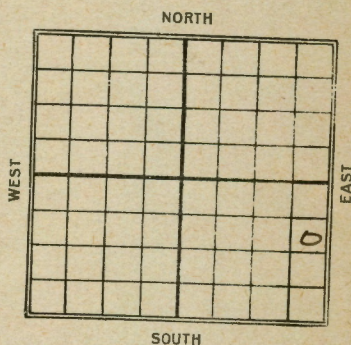


REPORT

6/18 Spud
7/16 Skidding rig at 400'
10/8 Gas Sand 2310-30
 Oil 2330-82
 T.D. 2386 120 gts
 30 Bbls

Map No. K Sec. 16 Twp. 23 R. 9Well No. 15 Teeter Farm _____Empire Company

NORTH

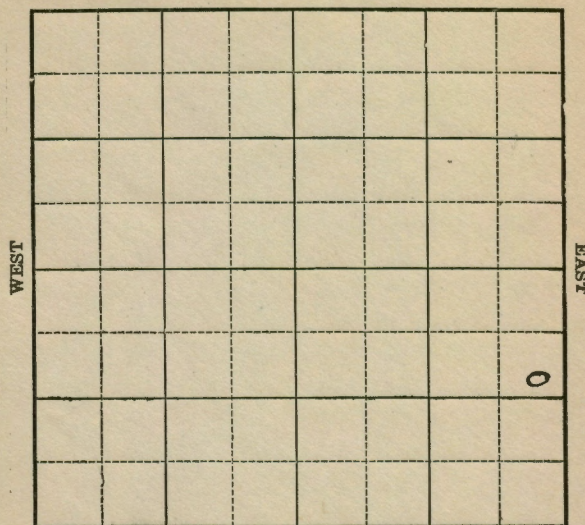

SOUTH

Location _____

Rig up _____

Drilling Remarks:

Drilling Remarks:

RECORD

Cased _____ in. _____ ft.

Sand _____

Gas _____

Oil _____

Total Depth _____

PRODUCTION

1st 24 hrs Nat. _____

1st 24 hrs. after shot _____

Gas _____ cu. ft.

Dry Hole _____

Abandoned _____

15 KANSAS Sec. 16 Twp. 23 R. 9
 Map No. 13 Leetle
 Well No. Empire Company
 Contractor

FIRST REPORT SECTION PLAT

1120 Ft. from N. Line
 _____ Ft. from S. Line
 200 Ft. from E. Line
 _____ Ft. from W. Line

Location _____
 Rig up _____
 Drilling and Remarks: *spud*
 Cased _____ in., _____ ft.
 Sand _____
 Gas _____
 Oil _____
 Total Depth _____
 PRODUCTION
 1st 24 hrs. Nat. _____
 1st 24 hrs. after shot _____
 Gas _____ Cu. Ft.
 Dry Hole _____
 Abandoned _____

Date JUN 18 1924
 M. A. BENEAR
 192 Scout

15 KANSAS Sec. 16 Twp. 23 R. 9
 Map No. 15 - Leetle
 Well No. Empire Company
 Contractor

COMPLETED SECTION PLAT

1120 Ft. from N. Line
 _____ Ft. from S. Line
 200 Ft. from E. Line
 _____ Ft. from W. Line

Location _____
 Rig up _____
 Drilling and Remarks: *Gas 1.2310-20*
W 2330-82
70.2386
180/30
 Cased _____ in., _____ ft.
 Sand _____
 Gas _____
 Oil _____
 Total Depth _____
 PRODUCTION
 1st 24 hrs. Nat. _____
 1st 24 hrs. after shot _____
 Gas _____ Cu. Ft.
 Dry Hole _____
 Abandoned _____

Date OCT 8 1924
 M. A. BENEAR
 192 Scout