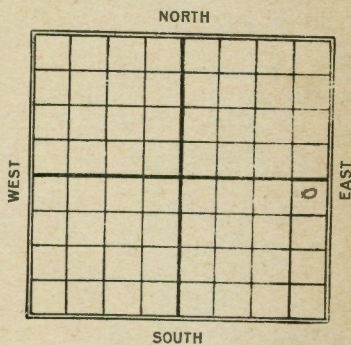
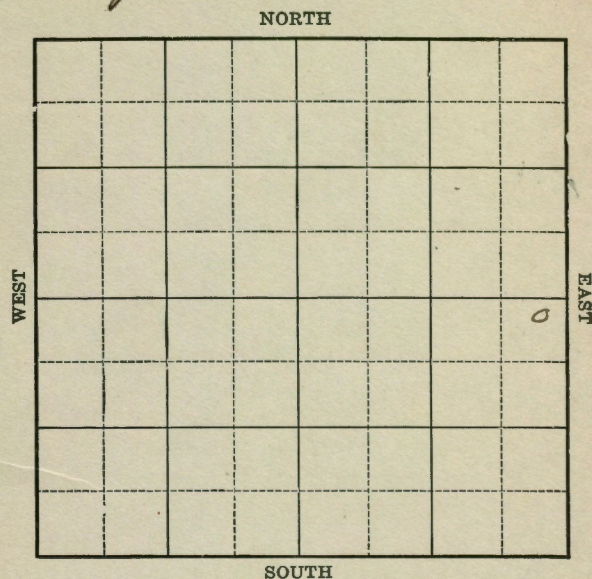


Map No. K Sec. 16 Twp. 23 R. 9Well No. 16 Teter FarmEmpire G. & F Company330 Ft. from N. Line     Ft. from S. Line330 Ft. from E. Line     Ft. from W. Line

Date

REPORT

192411/19 Location11/26 Rig12/17 D lg. 132519251/21 Top sand 2320-40 T.D.2388 in sand, shot8096 flowed 110 Bbls1st 12 hoursMap No. Kans Sec. 16 Twp. 23 R. 9Well No. 16 Teter FarmEmpire G. & F Company

Location

Rig Up

Drilling Remarks

Drilling Remarks

## RECORD

Cased      in.      ft.Sand     Gas     Oil     Total Depth     

## PRODUCTION

1st 24 hrs. Nat.     1st. 24 hrs. after shot     Gas      cu. ftDry Hole     Abandoned

Map No. 15 **KANSAS** Sec. 16 Twp. 23 R. 9Well No. 16 *Liter**Empire G & F* Company

Contractor

**COMPLETED**

## SECTION PLAT

|  |  |  |   |
|--|--|--|---|
|  |  |  |   |
|  |  |  |   |
|  |  |  | 0 |
|  |  |  |   |

330 Ft. from N. Line

Ft. from S. Line

330 Ft. from E. Line

Ft. from W. Line

Location

Rig up

Drilling and Remarks:

*Tap 2. 2320**7.0. 2340**7.0. 2328 in sand**80/110 at 12 hrs*

## RECORD

Cased in., ft.

Sand

Gas

Oil

Total Depth

## PRODUCTION

1st 24 hrs. Nat.

1st 24 hrs. after shot

Gas Cu. Ft.

Dry Hole

Abandoned

Date

1/21 1925**M. A. BENEAR**

Scout

Map No. 15 **KANSAS** Sec. 16 Twp. 23 R. 9Well No. 16 *Liter**Empire G & F* Company

Contractor

FIRST REPORT

## SECTION PLAT

|  |  |  |   |
|--|--|--|---|
|  |  |  |   |
|  |  |  |   |
|  |  |  | 0 |
|  |  |  |   |

330 Ft. from N. Line

Ft. from S. Line

330 Ft. from E. Line

Ft. from W. Line

Location

Rig up

Drilling and Remarks:

## RECORD

Cased in., ft.

Sand

Gas

Oil

Total Depth

## PRODUCTION

1st 24 hrs. Nat.

1st 24 hrs. after shot

Gas Cu. Ft.

Dry Hole

Abandoned

Date **NOV 19 1924**

192

**M. A. BENEAR**

Scout