


Map No. Kansas Sec. 16 Twp. 23 R. 9Well No. 25 Teeter FarmEmpire G. & F. Company

NORTH

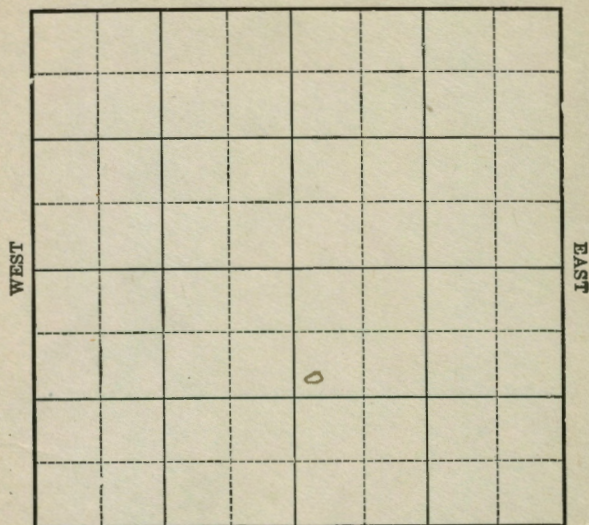

SOUTH

Location _____

Drilling Remarks _____

Rig Up _____

Drilling Remarks _____

RECORD

Cased _____ in. _____ ft.

Sand _____

Gas _____

Oil _____

Total Depth _____

PRODUCTION

1st 24 hrs. Nat. _____

1st. 24 hrs. after shot _____

Gas _____ cu. ft.

Dry Hole _____

Abandoned _____


Map No. Kansas Sec. 16 Twp. 23 R. 9Well No. 25 Teeter FarmEmpire Gas & Fuel Company

NORTH

990 Ft. from N. Line

_____ Ft. from S. Line

_____ Ft. from E. Line

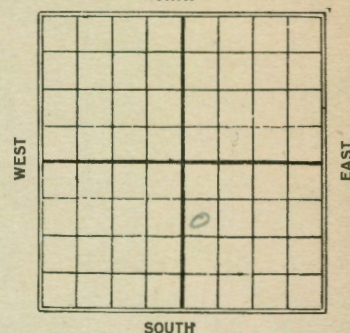330 Ft. from W. Line

SOUTH

Date

REPORT

5/29 Bldg Rig6/5 Rig6/12 Spud6/19 6507/3 15457/10 18507/17 24507/24 haul. 2477-2535'J.O. 2541 - 1st Oil 2492'200/175

Map No. *1/4 Sec 16* Sec. *16* Twp. *23* R. *9*Well No. *25* *Leet*Company *Empire Gas & Fuel Co.*

Contractor

SECTION PLAT

990 Ft. from N. Line

Ft. from S. Line

Ft. from E. Line

330 Ft. from W. Line

Completed

Location

Rig up

Drilling and Remarks:

*1st oil 2492'**200/175 bks*

RECORD

Cased in, ft.

Sand *2477-2535'*

Gas

Oil

Total Depth *2541' in hole*

PRODUCTION

1st 24 hrs. Nat.

1st 24 hrs. after shot

Gas Cu. Ft.

Dry Hole

Abandoned

Date

JUL 24 1925

192

CHAS. L. SHERWOOD

Scout

Map No. *1/4 Sec 16* Sec. *16* Twp. *23* R. *9*Well No. *25* *Leet*Company *Empire Gas & Fuel Co.*

Contractor

FIRST REPORTS

SECTION PLAT

990 Ft. from N. Line

Ft. from S. Line

Ft. from E. Line

330 Ft. from W. Line

Location

Rig up

Drilling and Remarks:

Blkg Reg

RECORD

Cased in, ft.

Sand

Gas

Oil

Total Depth

PRODUCTION

1st 24 hrs. Nat.

1st 24 hrs. after shot

Gas Cu. Ft.

Dry Hole

Abandoned

Date

MAY 29 1925

192

CHAS. L. SHERWOOD

Scout