


Map No. 1 Kansas Sec. 16 Twp. 23 R. 9Well No. 33 Teter Farm _____Empire G. & F. Company

NORTH

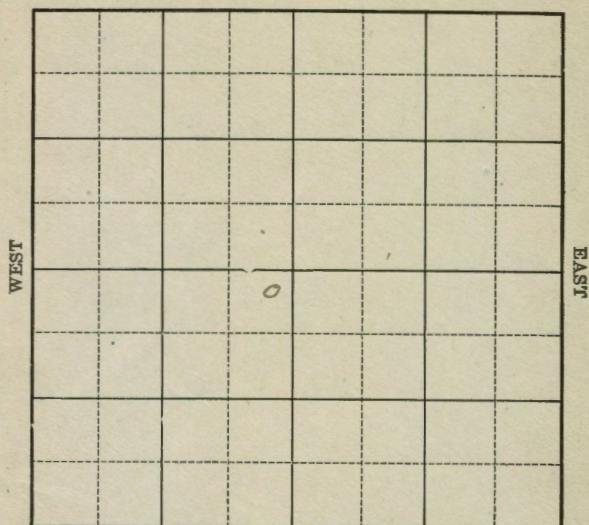

SOUTH

Location _____ Rig Up _____

Drilling Remarks _____ Drilling Remarks _____

RECORD

Cased _____ in. _____ ft.

Sand _____

Gas _____

Oil _____

Total Depth _____

PRODUCTION

1st 24 hrs. Nat. _____

1st 24 hrs. after shot _____

Gas _____ cu. ft.

Dry Hole _____

Abandoned _____

Map No. KANSAS Sec. 16 Twp. 23 R. 9Well No. 33 Teter Farm _____Empire G & F Company


NORTH

320 Ft. from N. Line

_____ Ft. from S. Line

320 Ft. from E. Line

_____ Ft. from W. Line

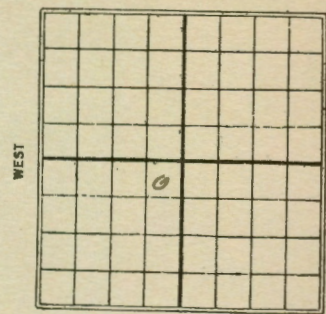

SOUTH

1926

Date

REPORT

2/10 Timbers2/17 Bldg rig.2/24 Slg 1210

3/5 _____

3/10 " 3003/18 " 10603/25 " 16504/1 " 20454/7 " 23154/14 Top Sd. 2479-2524. 1st
oil. 2496' shot 200/1200'
oil in hole swabbing
and cleaning out.4/21 Sd. - 2479-2524. oil
2496. 200/100 Brals.

K15 *Sherwood*
Map No. *16* KANSAS Sec. *23* Twp. *23* R. *9*Well No. *33* *Letor*
Empire Oil & Fuel Co Company

Contractor

COMPLETED

SECTION PLAT

330

Ft. from N. Line

Ft. from S. Line

330

Ft. from E. Line

Ft. from W. Line

Location

Rig up

Drilling and Remarks:

*oil 2496'**2009 100 BS.*

RECORD

Cased _____ in., _____ ft.

Sand *2479-2524*

Gas _____

Oil _____

Total Depth *2524*

PRODUCTION

1st 24 hrs. Nat. _____

1st 24 hrs. after shot _____

Gas _____ Cu. Ft.

Dry Hole _____

Abandoned _____

Date

APR 21 1926

CHAS. L. SHERWOOD

192

Scout

K15 *Sherwood*
Map No. *16* KANSAS Sec. *23* Twp. *23* R. *9*Well No. *33* *Letor*
Empire Oil & Fuel Co Company

Contractor

SECTION PLAT

330

Ft. from N. Line

Ft. from S. Line

330

Ft. from E. Line

Ft. from W. Line

FIRST REPORTS

Location

Rig up *Timber*

Drilling and Remarks:

RECORD

Cased _____ in., _____ ft.

Sand _____

Gas _____

Oil _____

Total Depth _____

PRODUCTION

1st 24 hrs. Nat. _____

1st 24 hrs. after shot _____

Gas _____ Cu. Ft.

Dry Hole _____

Abandoned _____

Date

FEB 10 1926

CHAS. L. SHERWOOD

192

Scout