


Map No. Kansas Sec. 16 Twp. 23 R. 9Well No. 30 Teeter FarmEmpire G. & F. Company

NORTH

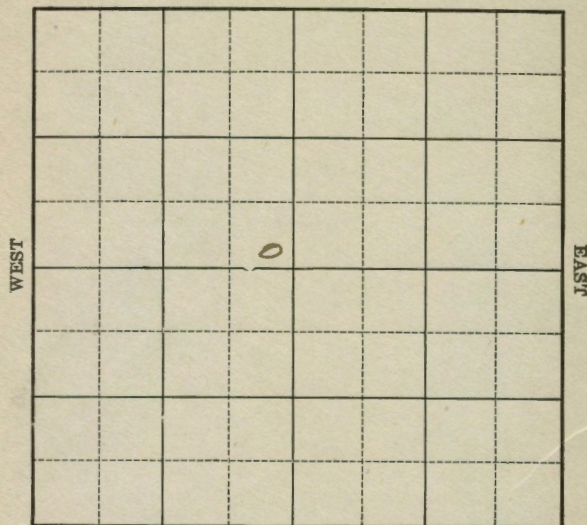

SOUTH

Location _____ Rig Up _____

Drilling Remarks _____ Drilling Remarks _____

RECORD		PRODUCTION	
Cased _____ in. _____ ft.		1st 24 hrs. Nat. _____	
Sand _____		1st 24 hrs. after shot _____	
Gas _____		Gas _____ cu. ft.	
Oil _____		Dry Hole _____	
Total Depth _____		Abandoned _____	


Map No. Kansas Sec. 16 Twp. 23 R. 9Well No. 30 Teeter FarmEmpire G. & F. Company

NORTH

_____ Ft. from N. Line

330 Ft. from S. Line330 Ft. from E. Line

_____ Ft. from W. Line

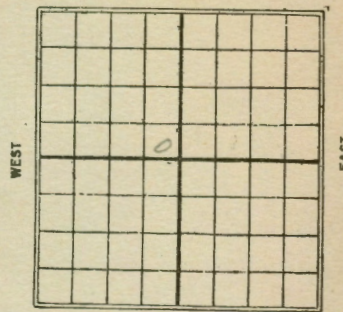

SOUTH

Date

REPORT

1925
11/13 Timbers
11/19 ---
11/27 Big
12/3 ---
12/17 Drlg 540'
12/23 S. D. 920'
12/31 Drlg 1250'
1936
1/8 Drlg 1580'
1/14 ✓ 2175'
50 Top sand 2475-2535'
900' oil in hole.
1/17 150 bbls. Sand 2475-2535'
S. D. 2535'

15 KANSAS Sec. 16 Twp. 23 R. 9

Well No. 30 Leton
Empire Oil & Gas Co. Company

Contractor

COMPLETED

SECTION PLAT

Ft. from N. Line

330

Ft. from S. Line

330

Ft. from E. Line

Ft. from W. Line

Location

RECORD

Cased in. ft.

Sand 2475-2535

Gas

Oil

Total Depth 2535

PRODUCTION

1st 24 hrs. Nat.

1st 24 hrs. after shot

Gas Cu. Ft.

Dry Hole

Abandoned

Date

JAN 27 1926

192

CHAS. L. SHERWOOD

Scout

K15 KANSAS Sec. 16 Twp. 23 R. 9

Well No. 30 Leton
Empire Oil & Gas Co. Company

Contractor

FIRST REPORTS

SECTION PLAT

Ft. from N. Line

330

Ft. from S. Line

330

Ft. from E. Line

Ft. from W. Line

Location

RECORD

Cased in. ft.

Sand

Gas

Oil

Total Depth

PRODUCTION

1st 24 hrs. Nat.

1st 24 hrs. after shot

Gas Cu. Ft.

Dry Hole

Abandoned

Date

NOV 13 1925

192

CHAS. L. SHERWOOD

Scout