


Map No. Kansas Sec. 16 Twp. 23 R. 9
 Well No. 31 Teeter Farm
Empire G. & F Company

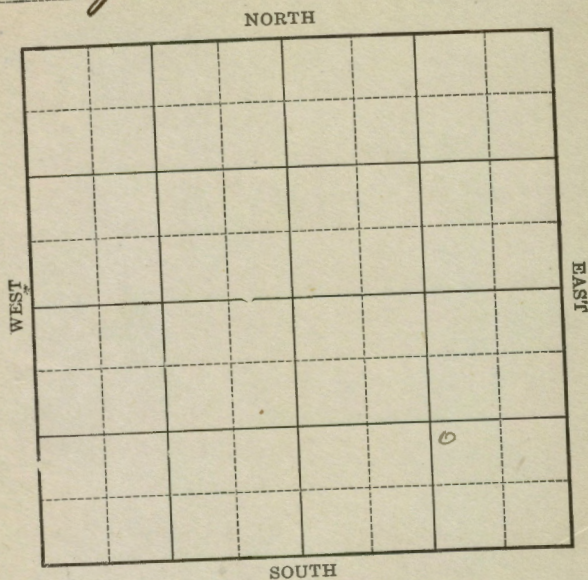

Location _____
 Drilling Remarks _____

Rig Up _____
 Drilling Remarks _____

RECORD


Cased _____ in. _____ ft.
 Sand _____
 Gas _____
 Oil _____
 Total Depth _____

PRODUCTION

1st 24 hrs. Nat. _____
 1st 24 hrs. after shot _____
 Gas _____ cu. ft.
 Dry Hole _____
 Abandoned _____

Map No. Kansas Sec. 16 Twp. 23 R. 9
 Well No. 31 Teeter Farm
Empire G. & F Company

_____ Ft. from N. Line
990 Ft. from S. Line
990 Ft. from E. Line
 _____ Ft. from W. Line

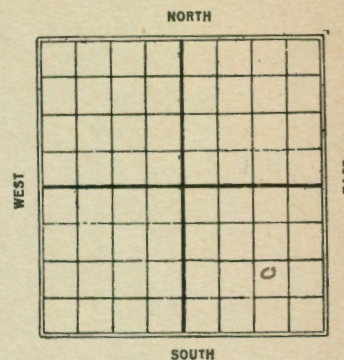

Date

REPORT

1925
12/17 Location

12/23 Bldg Rig

12/31 Rig

1926

1/8 Only 400'

1/14 ✓ 1030'

1/20 ✓ 1540'

1/27 ✓ 2150'

2/3 Sand 2387-2481

240 gts Pay 2421-76
 150 Bbls

15 KANSAS 16 23 R. 9
Map No. Sec. Twp. R.

Well No. 31 206 ft.
Campile 52 30

Company

Contractor

COMPLETED

SECTION PLAT

			0

Ft. from N. Line

990 Ft. from S. Line

990 Ft. from E. Line

Ft. from W. Line

Location

Rig up

Drilling and Remarks:

Day 242176

2409150 bhs.

RECORD

Cased in., ft.

Sand 2387-2421

Gas

Oil

Total Depth 2481

PRODUCTION

1st 24 hrs. Nat.

1st 24 hrs. after shot.

Gas Cu. Ft.

Dry Hole

Abandoned

Date

FEB 3 1926

192 CHAS. L. SHERWOOD Scout

KANSAS 15 16 23 R. 9
Map No. Sec. Twp. R.

Well No. 31 206 ft.
Campile 52 30

Company

Contractor

FIRST REPORTS

SECTION PLAT

			700

Ft. from N. Line

990 Ft. from S. Line

990 Ft. from E. Line

710 Ft. from W. Line Located hole

Location

Rig up

Drilling and Remarks:

RECORD

Cased in., ft.

Sand

Gas

Oil

Total Depth

PRODUCTION

1st 24 hrs. Nat.

1st 24 hrs. after shot.

Gas Cu. Ft.

Dry Hole

Abandoned

Date

DEC 17 1925

192 CHAS. L. SHERWOOD Scout