


Greenwood

KANCAS

SECTION 16 TOWNSHIP 23S RANGE 9E
WELL NO. #84 Teter Unit
COMPANY Cities Service

NORTH S/2 N/2 SW/4

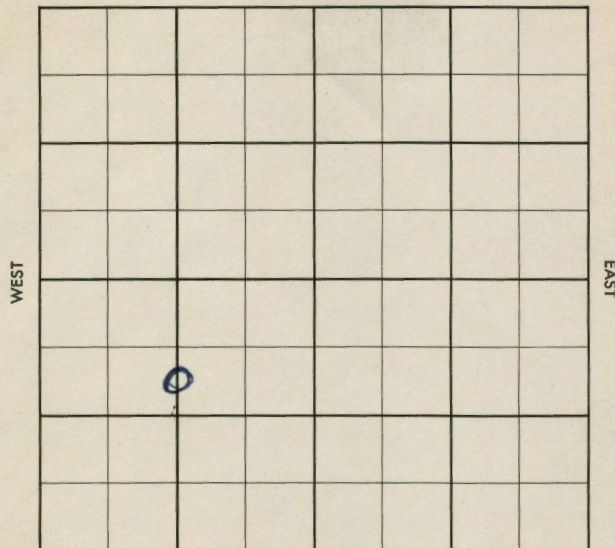

SOUTH

County Greenwood Elev. 1581 GR
 Sec. 16 Twp. 23S Rge. 9E
 Company Cities Service
 FarmName Teter Unit No. 84

TOPS	DEPTH	LOG	DATUM	Loc. in Sec.
Anh.				$S\frac{1}{2} N\frac{1}{2} SW\frac{1}{4}$
T.P.				
H.				
Tr.				
Dg.				
B.P.	<u>Stv. Sd.</u>	<u>2507</u>		
L.				Geol.
K.C.				Contr.
B.K.C.				
Ce.				
C.				
M.				Pool
K.				<u>Teter</u>
Mz.				
Mo.				
V.				
S.				
A.				
R.				
PE.				
G.				
T.D.	<u>2572</u>			

FIRST REPORT

AUG 21 '57

COMPLETED

Date Comm. spud 7-31-57

10" 208 w/175 sx; RTD 2572; 7" 2518 w/100;

CO 2572; pmp 6 bo / 79 bw 13 hrs.

COMPLETE

County Greenwood Elev. 1581 GR
 Sec. 16 Twp. 23S Rge. 9E
 Company Cities Service
 FarmName Teter Unit No. 84

TOPS	DEPTH	LOG	DATUM	Loc. in Sec.
Anh.				$S\frac{1}{2} N\frac{1}{2} SW\frac{1}{4}$
T.P.				
H.				
Tr.				
Dg.				
B.P.	<u>Stv. Sd.</u>	<u>2507</u>		
L.				Geol.
K.C.				Contr.
B.K.C.				
Ce.				
C.				
M.				Pool
K.				<u>Teter</u>
Mz.				
Mo.				
V.				
S.				
S.				
A.				
R.				
PE.				
G.				
T.D.				

AUG 22 '57
COMPLETE

Date Comm. spud 7-31-57

10" 208 w/175 sx; RTD 2572; 7" 2518 w/100;

CO 2572; pmp 6 bo / 79 bw 13 hrs.

COMPLETE