


Map No. Kan Sec. 16 Twp. 23 R. 9
 Well No. 28 Teeter Farm
Empire G. & O. Company

NORTH

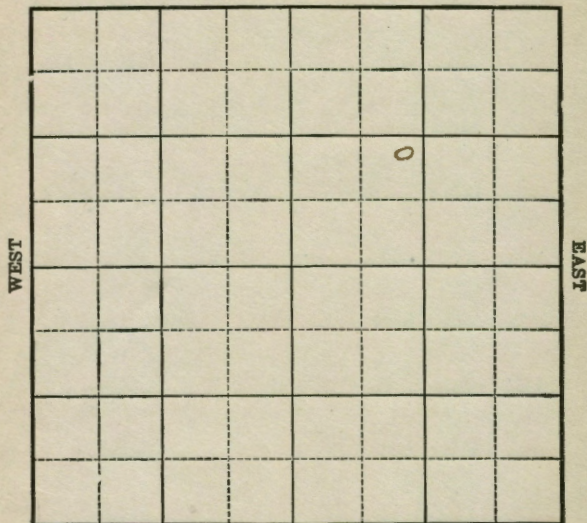

SOUTH

Location _____
 Drilling Remarks:

Rig Up _____
 Drilling Remarks:

RECORD

Cased _____ in. _____ ft.
 Sand _____
 Gas _____
 Oil _____
 Total Depth _____


PRODUCTION

1st 24 hrs. Nat. _____
 1st 24 hrs. after shot _____
 Gas _____ cu. ft.
 Dry Hole _____
 Abandoned _____

Map No. Kan Sec. 16 Twp. 23 R. 9
 Well No. 28 Teeter Farm
Empire Gas Fuel Co. Company

NORTH

_____ Ft. from N. Line
990 Ft. from S. Line
 _____ Ft. from E. Line
990 Ft. from W. Line

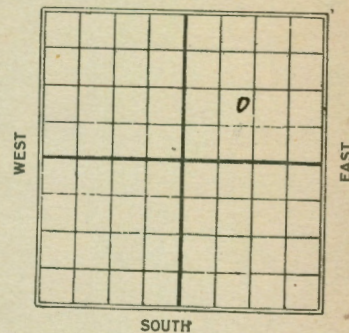

SOUTH

Date

REPORT

1925

6/26 Location

7/3 Bldg rig

7/10 Rig

7/17

7/24 Rig

7/31 Spudding

8/7

8/14 650

8/20 S.D. 1045 - for water

8/26 1500'

9/3 1550

9/11 S.D. 1730

9/16

9/24 + Only 1900

10/1 ✓ 2145

10/8 Top sand 2466-2537 - 1st trial 2491
2000' oil in hole will shoot.10/16 Sand 2464-2537 200 gals
175 Bbl

Map No. 16 Sec. 16 Twp. 23 R. 9
 Well No. 28 Lee Co
Capitol Oil & Fuel Co. Company
 Contractor

FIRST REPORTS

SECTION PLAT

Ft. from N. Line
990
 Ft. from S. Line
 Ft. from E. Line
990
 Ft. from W. Line

		G	

Location ☒

RECORD

Cased _____ in., _____ ft.
 Sand _____
 Gas _____
 Oil _____
 Total Depth _____

PRODUCTION

1st 24 hrs. Nat. _____
 1st 24 hrs. after shot _____
 Gas _____ Cu. Ft.
 Dry Hole _____
 Abandoned _____

Date

JUN 26 1925 CHAS. L. SHERWOOD
 192 _____ Scout

Map No. 16 Sec. 16 Twp. 23 R. 9
 Well No. 28 Lee Co
Capitol Oil & Fuel Co. Company
 Contractor

COMPLETED

SECTION PLAT

Ft. from N. Line
990
 Ft. from S. Line
 Ft. from E. Line
990
 Ft. from W. Line

		O	

Location _____

RECORD

Rig up _____
 Drilling and Remarks:

0.2 2491'

Cased _____ in., _____ ft.
 Sand 2464' - 2537'
 Gas _____
 Oil _____
 Total Depth 2537'

PRODUCTION

1st 24 hrs. Nat. _____
 1st 24 hrs. after shot _____
 Gas _____ Cu. Ft.
 Dry Hole _____
 Abandoned _____

Date

OCT 16 1925 CHAS. L. SHERWOOD
 192 _____ Scout