


Map No. 5 Sec. 15 Twp. 23 R. 9
Well No. 1 Teeter Farm
Phillips Pet Company

NORTH

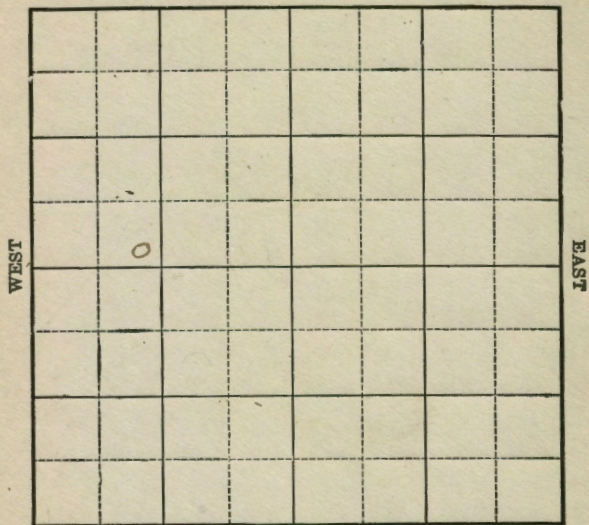

SOUTH

Location _____	Rig Up _____
Drilling Remarks: _____	Drilling Remarks: _____

Drilling Remarks:

Rig Up _____
Drilling Remarks:

Drilling Remarks:

RECORD

Cased _____ in. _____ ft.

Sand

Gas

Oil _____

Total Depth _____

PRODUCTION

1st 24 hrs. Nat. _____

1st 24 hrs. after shot_____

Gas _____ cu. ft.

Dry Hole

Abandoned _____

Map No. K Sec. 15 Twp. 23 R. 9^E
Well No. 1 Teeter Farm
Phillips Pet Company


NORTH

Ft. from N. Line

330 Ft. from S. Line

Ft. from E. Line

990 Ft. from W. Line

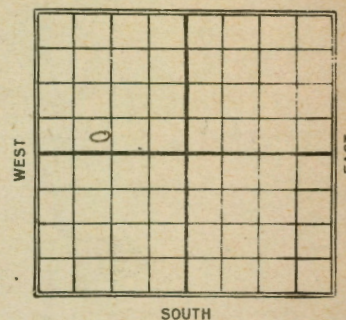

SOUTH

Date _____

REPORT

1924

10/8

11/12

R. O. G.

Top sand 2285'

F.O. 2302

Bottom sand 2366'

T.D. 2369' 110 qt

390 Bbs flowering

Map No. _____ Sec. 15 Twp. 23 R. 9Well No. 1 LeeterPhillips Pet Company_____
Contractor

SECTION PLAT

0			

Ft. from N. Line330 Ft. from S. Line_____
Ft. from E. Line990 Ft. from W. Line

Location _____

Rig up _____

Drilling and Remarks:

7 22 85
1st Oil 2302
Btm sand 2366
T.D. 2369
11085
390 All flowing

RECORD

Cased _____ in., _____ ft.

Sand _____

Gas _____

Oil _____

Total Depth _____

PRODUCTION

1st 24 hrs. Nat. _____

1st 24 hrs. after shot _____

Gas _____ Cu. Ft.

Dry Hole _____

Abandoned _____

Date

11/12 1924 M. A. Benear ScoutMap No. _____ Sec. 15 Twp. 23 R. 9 EWell No. 1 LeeterPhillips Pet Company_____
Contractor

FIRST REPORT

SECTION PLAT

0			

Ft. from N. Line330 Ft. from S. Line_____
Ft. from E. Line990 Ft. from W. Line

Location _____

Rig up _____

Drilling and Remarks:

R.O. G.

RECORD

Cased _____ in., _____ ft.

Sand _____

Gas _____

Oil _____

Total Depth _____

PRODUCTION

1st 24 hrs. Nat. _____

1st 24 hrs. after shot _____

Gas _____ Cu. Ft.

Dry Hole _____

Abandoned _____

Date

OCT 8 1924

192____M. A. BENEAR

Scout