


Map No. 1K Sec. 15 Twp. 23 R. 9
 Well No. 1 Teter Farm _____
Phillips Pet Company

NORTH

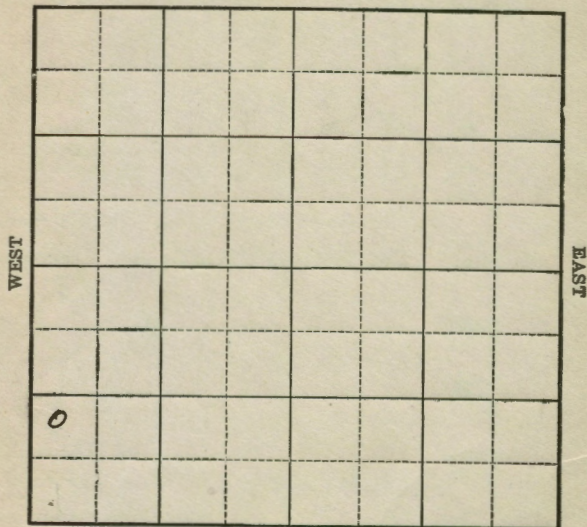

SOUTH

Location _____
 Drilling Remarks:

Rig Up _____
 Drilling Remarks:

RECORD

Cased _____ in. _____ ft.
 Sand _____
 Gas _____
 Oil _____
 Total Depth _____

PRODUCTION

1st 24 hrs. Nat. _____
 1st 24 hrs. after shot _____
 Gas _____ cu. ft.
 Dry Hole _____
 Abandoned _____

Map No. 1K Sec. 15 Twp. 23 R. 9
 Well No. 1 Teter Farm _____
Phillips Pet Company


Ft. from N. Line

990 Ft. from S. Line

Ft. from E. Line

330 Ft. from W. Line

NORTH

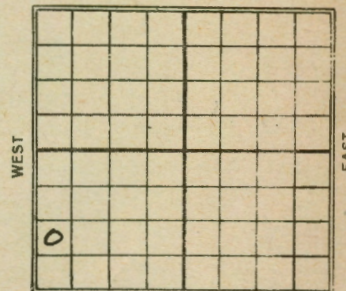

SOUTH

REPORT

1/24
4/23 Timbers
7/16 Tap. S. 2290 S.D.
10/8 Gas 2298-2328
Oil 2328-80 105 gts
20 Blbs

Map No. **KANSAS** Sec. **15** Twp. **23** R. **9**Well No. **1 Teter****Phillips Pet.** Company

Contractor

FIRST REPORT

SECTION PLAT

Ft. from N. Line

990 Ft. from S. Line

Ft. from E. Line

330 Ft. from W. Line

Location

Rig up

Drilling and Remarks:

Timber

RECORD

Cased in, ft.

Sand

Gas

Oil

Total Depth

PRODUCTION

1st 24 hrs. Nat.

1st 24 hrs. after shot

Gas Cu. Ft.

Dry Hole

Abandoned

Date **APR 23 1924****M. A. BENEAR**

192

Scout

Map No. **KANSAS** Sec. **15** Twp. **23** R. **9**Well No. **1 Teter****Phillips Pet.** Company

Contractor

COMPLETED

SECTION PLAT

Ft. from N. Line

990 Ft. from S. Line

Ft. from E. Line

330 Ft. from W. Line

Location

Rig up

Drilling and Remarks:

*201.2298-2328**oil 2328-80**105/20 + 116*

RECORD

Cased in, ft.

Sand

Gas

Oil

Total Depth

PRODUCTION

1st 24 hrs. Nat.

1st 24 hrs. after shot

Gas Cu. Ft.

Dry Hole

Abandoned

Date **OCT 8 1924****M. A. BENEAR**

192

Scout