


Map No. Kans Sec. 15 Twp. 23 R. 9Well No. 2 Jeter Farm
Phillips Company

NORTH

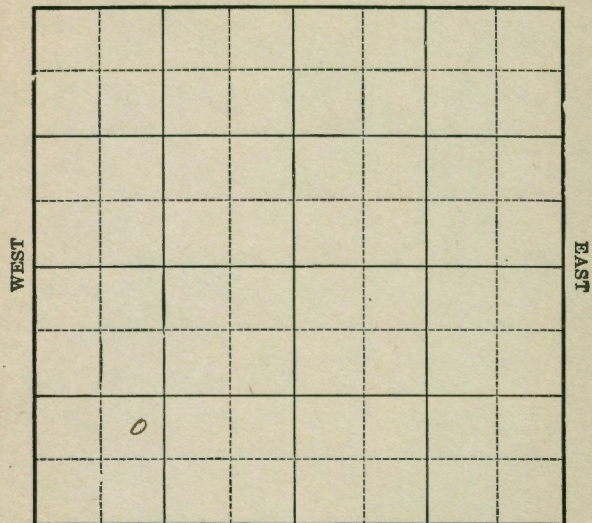

SOUTH

Location _____
Drilling Remarks _____Rig Up _____
Drilling Remarks _____

RECORD

Cased _____ in. _____ ft.
Sand _____
Gas _____
Oil _____
Total Depth _____

PRODUCTION


1st 24 hrs. Nat. _____
1st. 24 hrs. after shot _____
Gas _____ cu. ft.
Dry Hole _____
Abandoned _____Map No. Kansas Sec. 15 Twp. 23 R. 9Well No. 2 Jeter Farm
Phillips Company

NORTH

_____ Ft. from N. Line

990 Ft. from S. Line

_____ Ft. from E. Line

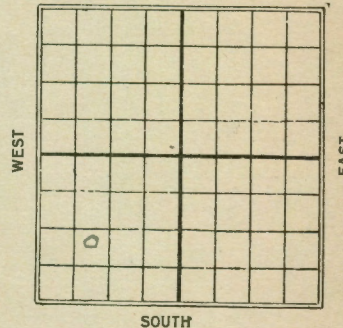990 Ft. from W. Line

SOUTH

Date

REPORT

19253/24Rig up5/1Top sand 23351st oil 2350-2393150 gts 200 Bbls

Map No. 15 **KANSAS** Sec. 15 Twp. 23 R. 9Well No. 2 FeterPhillips

Company

Contractor

FIRST REPORT

SECTION PLAT

Ft. from N. Line

990

Ft. from S. Line

Ft. from E. Line

990

Ft. from W. Line

Location

Rig up ✓✓

Drilling and Remarks:

RECORD

Cased in. ft.

Sand

Gas

Oil

Total Depth

PRODUCTION

1st 24 hrs. Nat.

1st 24 hrs. after shot

Gas

Cu. Ft.

Dry Hole

Abandoned

Date

3/24

192

M. A. BENEAR

Scout

Map No. 15 **KANSAS** Sec. 15 Twp. 23 R. 9Well No. 2 Feter (Bradford)PhillipsRobt Co

Company

Contractor

COMPLETED

SECTION PLAT

Ft. from N. Line

990

Ft. from S. Line

Ft. from E. Line

990

Ft. from W. Line

Location

Rig up

Drilling and Remarks:

24p to 2335' 1st
oil 2350-2393'154 200 bbls.

RECORD

Cased in. ft.

Sand

Gas

Oil

Total Depth

PRODUCTION

1st 24 hrs. Nat.

1st 24 hrs. after shot

Gas

Cu. Ft.

Dry Hole

Abandoned

Date

MAY 1 1925

192

CHAS. L. SHERWOOD

Scout