


Map No. K Sec. 15 Twp. 23 R. 9
 Well No. #2 Jeter Farm
Bittler + Mc Ginnis Company

NORTH

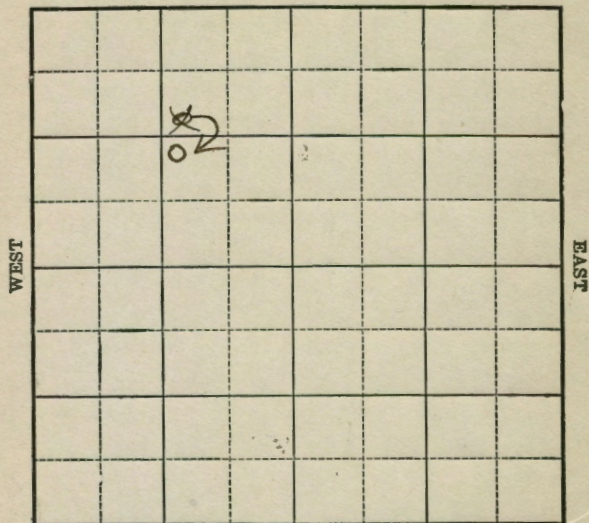

SOUTH

Location _____
 Drilling Remarks:

Rig Up _____
 Drilling Remarks:

RECORD

Cased _____ in. _____ ft.
 Sand _____
 Gas _____
 Oil _____
 Total Depth _____


PRODUCTION

1st 24 hrs. Nat. _____
 1st 24 hrs. after shot _____
 Gas _____ cu. ft.
 Dry Hole _____
 Abandoned _____

Map No. K Sec. 15 Twp. 23 R. 9
 Well No. 2 Jeter Farm
Bittler + Mc Ginnis Company

NORTH

990 Ft. from N. Line
 _____ Ft. from S. Line
990 Ft. from E. Line
 _____ Ft. from W. Line

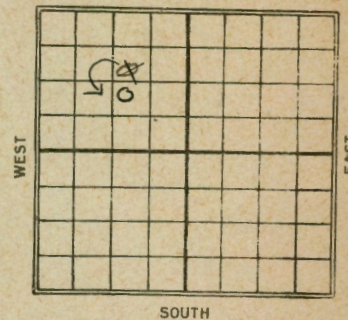

SOUTH

Date
1924

REPORT

11/12 Location
 11/26 Spudding
 12/17 2 Mi Gas. 2295-2305'
 F.O. 2305 D.Ly. @ 2365'
 1925
 1/14 2295-2305 2305-74
 T.D. 2375 11095 flowed
 600 Bbls 1st 12 hours
 now mky 450 Bbls

15 KANSAS
Map No. Sec. 15 Twp. 23 R. 9

Well No. 2 Peter
Bettler & M. C. Ginn's Company

Contractor

COMPLETED

SECTION PLAT

990 Ft. from N. Line
Ft. from S. Line
990 Ft. from E. Line
Ft. from W. Line

	2		

Location

Rig up

Drilling and Remarks:

2 M. C. Ginn 2295-2305
7.0.2305 to 2374
7.0.2375
110/gals flowed
600 bbls. lost 12 hrs.
now making 450 bbls.

RECORD

Cased in. ft.
Sand
Gas
Oil
Total Depth

PRODUCTION

1st 24 hrs. Nat.
1st 24 hrs. after shot
Gas Cu. Ft.
Dry Hole
Abandoned

Date

M. A. BENEAR

1925

Scout

15 KANSAS
Map No. Sec. 15 Twp. 23 R. 9

Well No. 2 Peter
Bettler & M. C. Ginn's Company

Contractor

FIRST REPORT

SECTION PLAT

990 Ft. from N. Line
Ft. from S. Line
990 Ft. from E. Line
Ft. from W. Line

	0		

Location

Rig up

Drilling and Remarks:

RECORD

Cased in. ft.
Sand
Gas
Oil
Total Depth

PRODUCTION

1st 24 hrs. Nat.
1st 24 hrs. after shot
Gas Cu. Ft.
Dry Hole
Abandoned

Date

NOV 12 1924

192

M. A. BENEAR

Scout