


Map No. Kans Sec. 15 Twp. 23 R. 9 ✓Well No. 3 Teter Farm
Shelly Company

NORTH

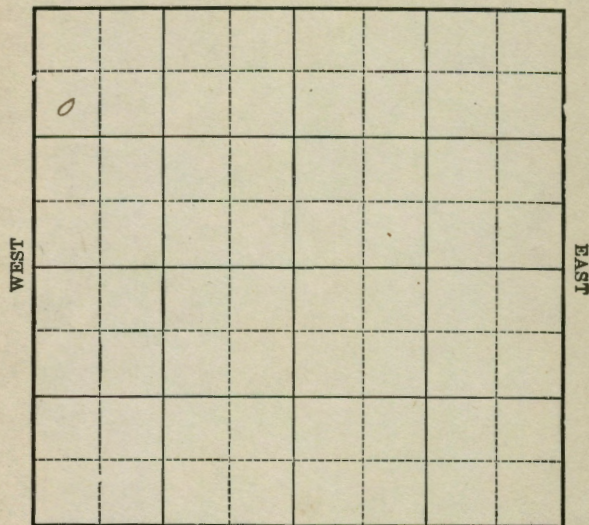

SOUTH

Location _____
Drilling Remarks _____Rig Up _____
Drilling Remarks _____

RECORD

Cased _____ in. _____ ft.
Sand _____
Gas _____
Oil _____
Total Depth _____

PRODUCTION


1st 24 hrs. Nat. _____
1st. 24 hrs. after shot _____
Gas _____ cu. ft.
Dry Hole _____
Abandoned _____Map No. Kansas Sec. 15 Twp. 23 R. 9Well No. 3 Teter Farm
Shelly Company

NORTH

990 Ft. from N. Line

_____ Ft. from S. Line

_____ Ft. from E. Line

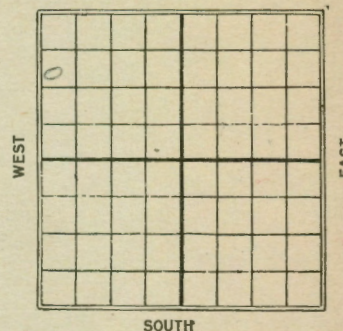330 Ft. from W. Line

REPORT

Date

1/25R.O.G.5/15Top Sand 2327 1 m. Sand2342 @2355-97 100 gts 400 lbs

Map No. 15 **KANSAS** Sec. 15 Twp. 23 R. 9Well No. 3 Feter
Shelly Company
Contractor

FIRST REPORT

SECTION PLAT

990 Ft. from N. Line

Ft. from S. Line

Ft. from E. Line

330 Ft. from W. Line

0			

Location

Rig up

Drilling and Remarks:

R.O. G.

RECORD

Cased in., ft.

Sand

Gas

Oil

Total Depth

PRODUCTION

1st 24 hrs. Nat.

1st 24 hrs. after shot

Gas Cu. Ft.

Dry Hole

Abandoned

Date

3/24/5

M. A. BENEAR

Scout

Map No. 15 **KANSAS** Sec. 15 Twp. 23 R. 9Well No. 3 Feter
Shelly Company
Contractor

COMPLETED

SECTION PLAT

990 Ft. from N. Line

Ft. from S. Line

Ft. from E. Line

330 Ft. from W. Line

0			

Location

Rig up

Drilling and Remarks:

Top at 2327' 1m
gas 2342' oil
2355-97' in Ahd100/400 b/s

RECORD

Cased in., ft.

Sand

Gas

Oil

Total Depth 2397

PRODUCTION

1st 24 hrs. Nat.

1st 24 hrs. after shot

Gas Cu. Ft.

Dry Hole

Abandoned

Date

MAY 15 1925

192

CHAS. L. SHERWOOD

Scout