


Map No. 15 Sec. 15 Twp. 23 R. 9Well No. 4 - Peter FarmSkelly oil co. Company

NORTH

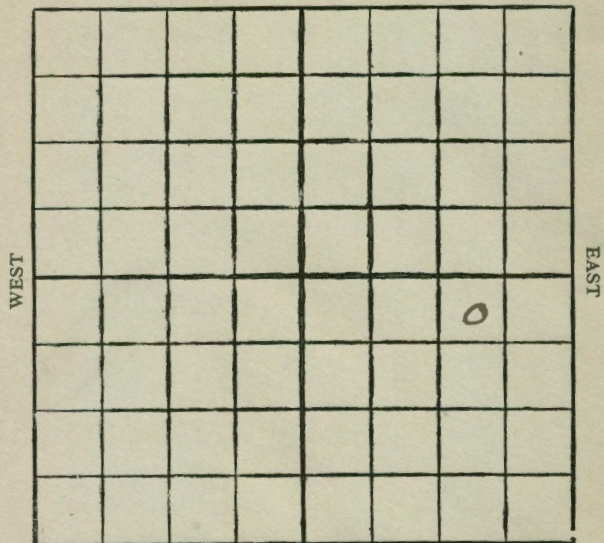

SOUTH

Location
Drilling RemarksRig Up
Drilling Remarks

RECORD

Cased _____ in. _____ ft.

Sand _____

Gas _____

Oil _____

Total Depth _____

PRODUCTION

1st 24 hrs. Nat. _____

1st 24 hrs. after shot _____

Gas _____ cu. ft.

Dry Hole _____

Abandoned _____

Map No. 15 Sec. 15 Twp. 23 R. 9Well No. 4 - Peter FarmSkelly oil co. Company


NORTH

330 Ft. from N. Line

_____ Ft. from S. Line

990 Ft. from E. Line

_____ Ft. from W. Line

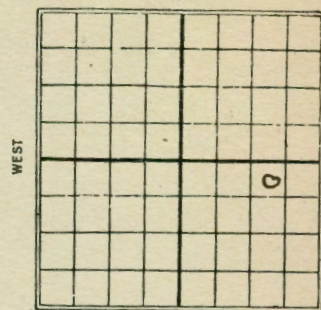

SOUTH

1927

Date

REPORT

1/6 Bldg rig1/13 Rig1/19 spudding1/26 spud 2002/3 Drlg 6152/10 " 14302/17 " 17302/24 sand 2274-2335T.D. 2352 - filled 700'will shoot3/2 sand 2274-2335120/40 bblJ.D. 2352

15 KANSAS
Map No. 15 Sec. 15 Twp. 23 R. 9
Well No. 4 20 ton

Skelly oil Co

Company

Contractor

FIRST REPORTS

SECTION PLAT

330 Ft. from N. Line
Ft. from S. Line
990 Ft. from E. Line
Ft. from W. Line

			0

Location

Rig up

Drilling and Remarks:

Blog rig

RECORD

Cased in, ft.
Sand
Gas
Oil
Total Depth

PRODUCTION

1st 24 hrs. Nat.
1st 24 hrs. after shot
Gas Cu. Ft.
Dry Hole
Abandoned

Date

JAN 6 1927

CHAS. L. SHERWOOD

192

Scout

15 KANSAS
Map No. 15 Sec. 15 Twp. 23 R. 9
Well No. 4 20 ton

Skelly oil Co

Company

Contractor

COMPLETED

SECTION PLAT

330 Ft. from N. Line
Ft. from S. Line
990 Ft. from E. Line
Ft. from W. Line

			0

Location

Rig up

Drilling and Remarks:

126 40 blo.

RECORD

Cased in, ft.
Sand 2274-2335
Gas
Oil
Total Depth 2352

PRODUCTION

1st 24 hrs. Nat.
1st 24 hrs. after shot
Gas Cu. Ft.
Dry Hole
Abandoned

Date

MAR 2 1927

192

CHAS. L. SHERWOOD

Scout