

Map No. Kansas Sec. 15 Twp. 23 R. 9

Well No. 3 Teeter Farm


Phillips Pet Company

Ft. from N. Line

990 Ft. from S. Line

990 Ft. from E. Line


Ft. from W. Line

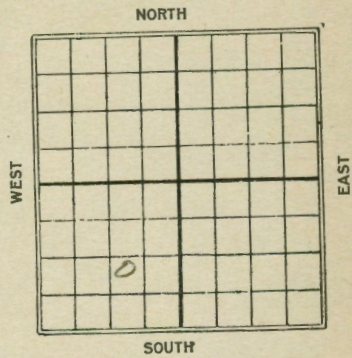

Map No. Kansas Sec. 15 Twp. 23 R. 9

Well No. 3 Teeter Farm

Phillips Pet Co. Company

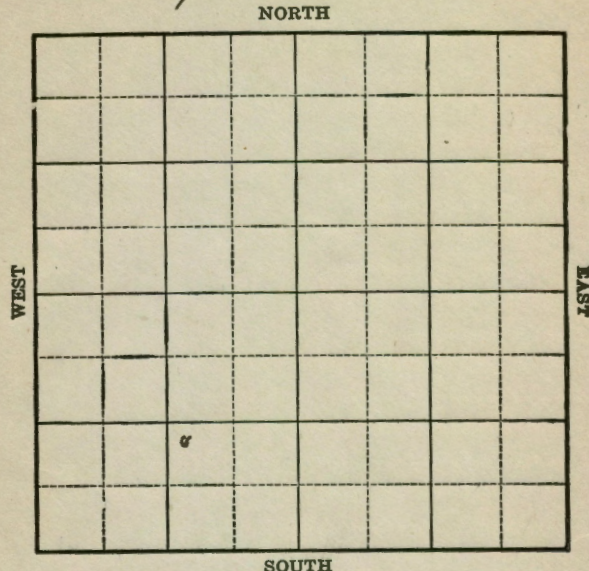

Date REPORT

1945
4/17 R.O.G.
5/29 S.G. 1350
6/5 S.D. 1510
6/12 ~~2290~~ Running 6" 2291 T.O.
6/18 2290-2386 120 gals
 150 Bbls

Location _____

Drilling Remarks: _____

Rig Up _____

Drilling Remarks: _____

RECORD

Cased _____ in. _____ ft.
 Sand _____
 Gas _____
 Oil _____
 Total Depth _____

PRODUCTION

1st 24 hrs. Nat. _____
 1st 24 hrs. after shot _____
 Gas _____ cu. ft.
 Dry Hole _____
 Abandoned _____

Map No. *12 1/2* Sec. *15* Twp. *23* R. *9*

Well No. *3 feet*

Phillip Oil Co Company

Contractor

FIRST REPORTS

SECTION PLAT

Ft. from N. Line

990 Ft. from S. Line

990 Ft. from E. Line

Ft. from W. Line

	o		

Location

Rig up *on ground*

Drilling and Remarks:

RECORD

Cased in., ft.

Sand

Gas

Oil

Total Depth

PRODUCTION

1st 24 hrs. Nat.

1st 24 hrs. after shot

Gas Cu. Ft.

Dry Hole

Abandoned

Date

APR 17 1925

192

Chas. L. Sherwood Scout

Map No. *12 1/2* Sec. *15* Twp. *23* R. *9*

Well No. *3 feet*

Phillip Oil Co Company

Contractor

COMPLETED

SECTION PLAT

Ft. from N. Line

990 Ft. from S. Line

990 Ft. from E. Line

Ft. from W. Line

	o		

Location

Rig up

Drilling and Remarks:

1st ad 2335'

120/150 bks

RECORD

Cased in., ft.

Sand *2290-2386*

Gas

Oil

Total Depth *2386'*

PRODUCTION

1st 24 hrs. Nat.

1st 24 hrs. after shot

Gas Cu. Ft.

Dry Hole

Abandoned

Date

JUN 18 1925

192

CHAS. L. SHERWOOD Scout