
Form 252A 5M 8-24 16529

Map No. Kans Sec. 15 Twp. 23 R 9

Well No. #3 Teter Farm

Phillips Pet Company

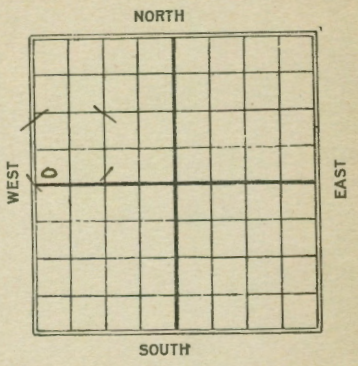

____ Ft. from N. Line

330 Ft. from S. Line

____ Ft. from E. Line

330 Ft. from W. Line


Date 1924	REPORT
12/11	Rig & Tools
12/17	spudding.
1925	
1/24	Dlg 2015
3/1	Ø 2285 F.O. 2306-28
	Shale 2328-40
	Best Pay 2340-73
	T.D. 2375 115 gts 150 Bbls

Form 51 5M 8-24 16567

Map No. Kans Sec. 15 Twp. 23 R. 9 ✓

Well No. #3 Teter Farm

Phillips Pet Company

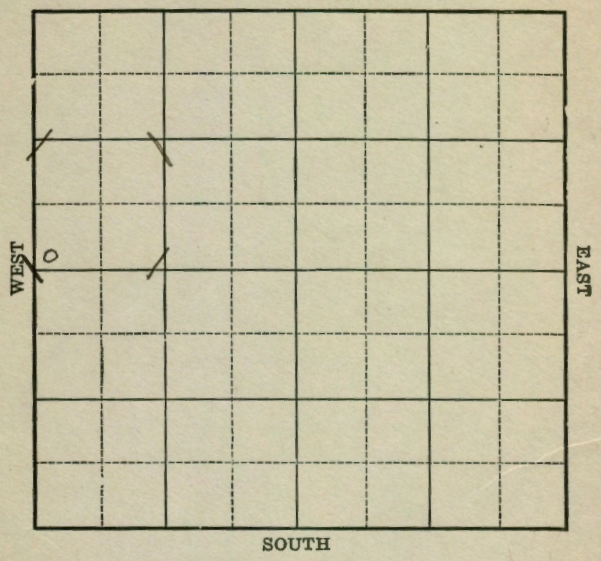

Location ____ Rig Up ____

Drilling Remarks Drilling Remarks

RECORD

Cased ____ in. ____ ft.

Sand ____

Gas ____

Oil ____

Total Depth ____

PRODUCTION

1st 24 hrs. Nat. ____

1st. 24 hrs. after shot ____

Gas ____ cu. ft.

Dry Hole ____

Abandoned ____

Form 26—1M Bks.—3-23—11959.

15 KANSAS

Map No. ____ Sec. 15 Twp. 23 R. 9


Well No. # 3 Teter

Phillips Pet Company

____ Contractor

FIRST REPORT

SECTION PLAT

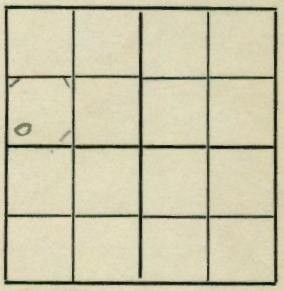

____ Ft. from N. Line

330 Ft. from S. Line

____ Ft. from E. Line

330 Ft. from W. Line

Location ____

Rig up ____

Drilling and Remarks:

Rig + Tools

RECORD

Cased ____ in., ____ ft.

Sand ____

Gas ____

Oil ____

Total Depth ____

PRODUCTION

1st 24 hrs. Nat. ____

1st 24 hrs. after shot ____

Gas ____ Cu. Ft.

Dry Hole ____

Abandoned ____

Date DEC 11 1924

192__

M. A. BENEAR

____ Scout

Form 26—1M Bks.—3-23—11959.

15 KANSAS

Map No. ____ Sec. 15 Twp. 23 R. 9


Well No. 3 Teter

Phillips Pet Company

____ Contractor

COMPLETED

SECTION PLAT

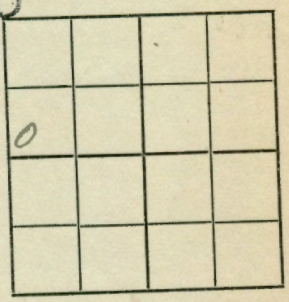

____ Ft. from N. Line

330 Ft. from S. Line

____ Ft. from E. Line

330 Ft. from W. Line

Location ____

Rig up ____

Drilling and Remarks:

Tops. 2280

T.D. 2306-28

shale 2328-40

1st Pay 2340-73

T.D. 2375

115/150 Hole

RECORD

Cased ____ in., ____ ft.

Sand ____

Gas ____

Oil ____

Total Depth ____

PRODUCTION

1st 24 hrs. Nat. ____

1st 24 hrs. after shot ____

Gas ____ Cu. Ft.

Dry Hole ____

Abandoned ____

Date 3/1

192 3

M. A. BENEAR

____ Scout