


Map No. Kansas Sec. 15 Twp. 23 R. 9 ✓
 Well No. 4 Teter Farm
Phillips Pet Company

NORTH

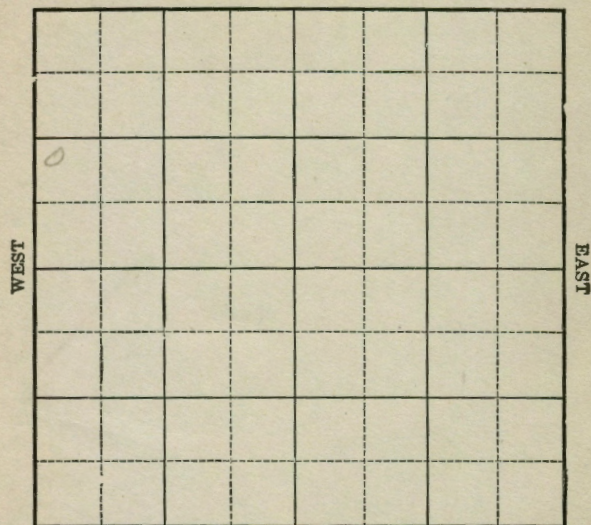

SOUTH

Location _____
 Drilling Remarks _____

Rig Up _____
 Drilling Remarks _____

RECORD

Cased _____ in. _____ ft.
 Sand _____
 Gas _____
 Oil _____
 Total Depth _____


PRODUCTION

1st 24 hrs. Nat. _____
 1st 24 hrs. after shot _____
 Gas _____ cu. ft.
 Dry Hole _____
 Abandoned _____

Map No. Kansas Sec. 15 Twp. 23 R. 9
 Well No. 4 Teter Farm
Phillips Pet Company

NORTH

_____ Ft. from N. Line
990 Ft. from S. Line
 _____ Ft. from E. Line
330 Ft. from W. Line

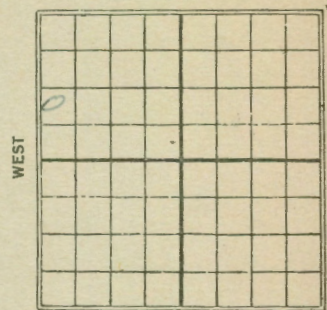

SOUTH

Date

REPORT

19253/1Rig up4/17\$ 2317 Oil 2335T. D. 2412170 gts 150 Bbls

Map No. 15 Sec. 15 Twp. 23 R. 9Well No. 4 TetuP Phillips Pet Company

Contractor

FIRST REPORT

Ft. from N. Line

990 Ft. from S. Line

Ft. from E. Line

330 Ft. from W. Line

SECTION PLAT

Location

Rig up ✓✓

Drilling and Remarks:

RECORD

Cased _____ in., _____ ft.

Sand _____

Gas _____

Oil _____

Total Depth _____

PRODUCTION

1st 24 hrs. Nat. _____

1st 24 hrs. after shot. _____

Gas _____ Cu. Ft.

Dry Hole _____

Abandoned _____

Date

3/11925M. A. BENEAN ScoutMap No. 15 Sec. 15 Twp. 23 R. 9Well No. 4 TetuPhillips Pet Co Company

Contractor

COMPLETED

SECTION PLAT

Ft. from N. Line

990 Ft. from S. Line

Ft. from E. Line

330 Ft. from W. Line

Location

Rig up

Drilling and Remarks:

2nd 2317' 1st
2nd 2335' 1st 2412'177 150 bbls

RECORD

Cased _____ in., _____ ft.

Sand _____

Gas _____

Oil _____

Total Depth _____

PRODUCTION

1st 24 hrs. Nat. _____

1st 24 hrs. after shot. _____

Gas _____ Cu. Ft.

Dry Hole _____

Abandoned _____

Date

APR 17 1925

1925W. L. Sheppard Scout