


Map No. Kane Sec. 15 Twp. 23 R. 9EWell No. #4 Jeter Farm
Skelly Company

NORTH

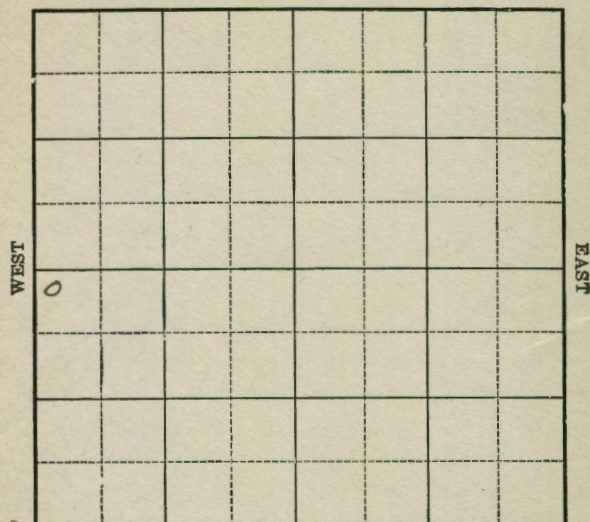

SOUTH

Location _____
Drilling Remarks _____Rig Up _____
Drilling Remarks _____

RECORD

Cased _____ in. _____ ft.
Sand _____
Gas _____
Oil _____
Total Depth _____

PRODUCTION


1st 24 hrs. Nat. _____
1st. 24 hrs. after shot _____
Gas _____ cu. ft.
Dry Hole _____
Abandoned _____Map No. K Sec. 15 Twp. 23 R. 9EWell No. #4 Jeter Farm
Skelly Company

NORTH

330 Ft. from N. Line

_____ Ft. from S. Line

_____ Ft. from E. Line

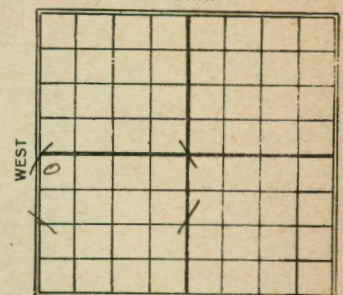330 Ft. from W. Line

SOUTH

Date

1924

REPORT

11/19Location11/26Rig Bldg12/172 by, spudding.19251/21Dly 625'3/12288 F.O. 2311Bottom Sand 2393T.D. 2397 160 gals150 Bbls

Map No. 15 **KANSAS** Sec. 15 Twp. 23 R. 9Well No. 4 Peter
Skelly Oil Company
Contractor**COMPLETED**

SECTION PLAT

330 Ft. from N. Line

Ft. from S. Line

Ft. from E. Line

330 Ft. from W. Line

0			

Location

Rig up

Drilling and Remarks:

Tap 228870.2311Bottom 1.239370.2397'160/180 ft.

RECORD

Cased in, ft.

Sand

Gas

Oil

Total Depth

PRODUCTION

1st 24 hrs. Nat.

1st 24 hrs. after shot

Gas Cu. Ft.

Dry Hole

Abandoned

Date

3/1 1925**M. A. BENEAR**

Scout

Map No. 15 **KANSAS** Sec. 15 Twp. 23 R. 9Well No. #4 Peter
Skelly Company
Contractor**FIRST REPORT**

SECTION PLAT

330 Ft. from N. Line

Ft. from S. Line

Ft. from E. Line

330 Ft. from W. Line

0			

Location

Rig up

Drilling and Remarks:

RECORD

Cased in, ft.

Sand

Gas

Oil

Total Depth

PRODUCTION

1st 24 hrs. Nat.

1st 24 hrs. after shot

Gas Cu. Ft.

Dry Hole

Abandoned

Date

NOV 19 1924

192

M. A. BENEAR

Scout