


Greenwood

Map No. *Kans* Sec. *15* Twp. *23* R. *9*

Well No. *4 Teter* Farm

Mc Ginnis etal Company

NORTH

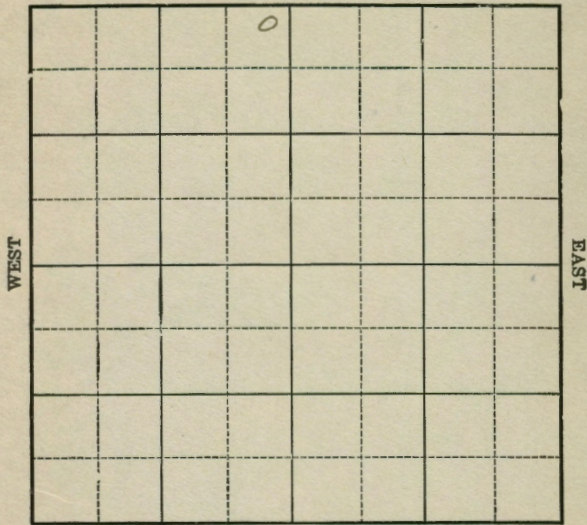

SOUTH

Location _____

Drilling Remarks _____

Rig Up _____

Drilling Remarks _____

RECORD

Cased _____ in. _____ ft.

Sand _____

Gas _____

Oil _____

Total Depth _____

PRODUCTION

1st 24 hrs. Nat. _____

1st. 24 hrs. after shot _____

Gas _____ cu. ft.

Dry Hole _____

Abandoned _____

Greenwood

Map No. *Kans* Sec. *15* Twp. *23* R. *9*

Well No. *4 Teter* Farm

Mc Ginnis etal Company


NORTH

330 Ft. from N. Line

_____ Ft. from S. Line

330 Ft. from E. Line

_____ Ft. from W. Line

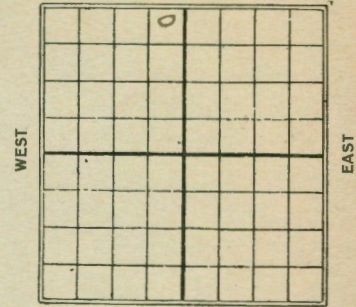

SOUTH

Date
1924

REPORT

12/30 *Timbers*

1925

1/21 *Rig*

3/30 *2330-2409 Oil 2332-2409*

T.D. 2419 Shot 160 gts

200 Bbls

Form 26-1M Bks.-3-23-11959. *Greenwood*
 Map No. *15* Sec. *15* Twp. *23* R. *9*
 Well No. *4 Leter*
McGinnis et al Company
 Contractor

FIRST REPORTS

SECTION PLAT

330' Ft. from N. Line
 _____ Ft. from S. Line
330' Ft. from E. Line
 _____ Ft. from W. Line

		0		

Location _____
 Rig up _____
 Drilling and Remarks:

Timbers

RECORD
 Cased _____ in., _____ ft.
 Sand _____
 Gas _____
 Oil _____
 Total Depth _____

PRODUCTION
 1st 24 hrs. Nat. _____
 1st 24 hrs. after shot _____
 Gas _____ Cu. Ft.
 Dry Hole _____
 Abandoned _____

Date *12-30* 192*4* *M.A.B.* Scout

Form 26-1M Bks.-3-23-11959.
 Map No. *15* **KANSAS** Sec. *15* Twp. *23* R. *9*
 Well No. *4 Leter*
McGinnis et al Company
 Contractor

COMPLETED SECTION PLAT

330 Ft. from N. Line
 _____ Ft. from S. Line
330 Ft. from E. Line
 _____ Ft. from W. Line

		0		

Location _____
 Rig up _____
 Drilling and Remarks:

shot 160 ft.

RECORD
 Cased _____ in., _____ ft.
 Sand *2330 - 2409*
 Gas _____
 Oil *2332 - 2409*
 Total Depth *2419*

PRODUCTION
 1st 24 hrs. Nat. _____
 1st 24 hrs. after shot *200*
 Gas _____ Cu. Ft.
 Dry Hole _____
 Abandoned _____

Date *3/30* 192*5* **M. A. BENEAR** Scout