


Map No. Kansas Sec. 15 Twp. 23 R. 9

Well No. 6 Teter Farm

Mc Ginnis et al Company

NORTH

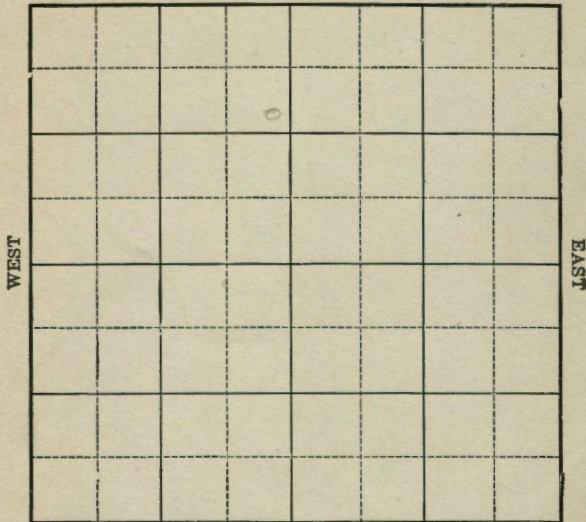

SOUTH

Location \_\_\_\_\_

Drilling Remarks \_\_\_\_\_

Rig Up \_\_\_\_\_

Drilling Remarks \_\_\_\_\_

RECORD

Cased \_\_\_\_\_ in. \_\_\_\_\_ ft.

Sand \_\_\_\_\_

Gas \_\_\_\_\_

Oil \_\_\_\_\_

Total Depth \_\_\_\_\_

PRODUCTION

1st 24 hrs. Nat. \_\_\_\_\_

1st. 24 hrs. after shot \_\_\_\_\_

Gas \_\_\_\_\_ cu. ft.

Dry Hole \_\_\_\_\_

Abandoned \_\_\_\_\_

Map No. Kansas Sec. 15 Twp. 23 R. 9

Well No. 6 Teter Farm

Mc Ginnis et al Company


NORTH

990 Ft. from N. Line

\_\_\_\_\_ Ft. from S. Line

330 Ft. from E. Line

\_\_\_\_\_ Ft. from W. Line

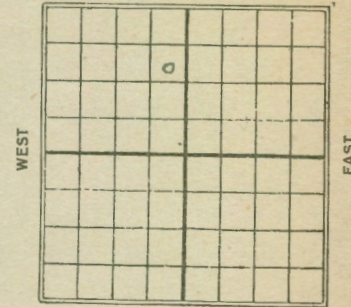

SOUTH

Date

1/25

REPORT

3/1

P.O.G.

4/4

2337-77

T.D. 2393

115 gals 100 Bbls

Map No. 15 Sec. 15 Twp. 22 R. 9

Well No. 6 2 feet

Mc Ginnis & al Company

Contractor

COMPLETED

SECTION PLAT

990 Ft. from N. Line

Ft. from S. Line

330 Ft. from E. Line

Ft. from W. Line

	o		

Location

Rig up

Drilling and Remarks:

115/100 bls

RECORD

Cased \_\_\_\_\_ in. \_\_\_\_\_ ft.

Sand 2337-2374

Gas \_\_\_\_\_

Oil \_\_\_\_\_

Total Depth 2393'

PRODUCTION

1st 24 hrs. Nat. \_\_\_\_\_

1st 24 hrs. after shot \_\_\_\_\_

Gas \_\_\_\_\_ Cu. Ft.

Dry Hole \_\_\_\_\_

Abandoned \_\_\_\_\_

Date

APR 24 1925

192

Chs L. Showood Scout

Map No. KANSAS Sec. 15 Twp. 23 R. 9

Well No. 6 2 feet

Mc Ginnis & al Company

Contractor

FIRST REPORT

SECTION PLAT

990 Ft. from N. Line

Ft. from S. Line

330 Ft. from E. Line

Ft. from W. Line

	o		

Location

Rig up

Drilling and Remarks:

R.O.S.

RECORD

Cased \_\_\_\_\_ in., \_\_\_\_\_ ft.

Sand \_\_\_\_\_

Gas \_\_\_\_\_

Oil \_\_\_\_\_

Total Depth \_\_\_\_\_

PRODUCTION

1st 24 hrs. Nat. \_\_\_\_\_

1st 24 hrs. after shot \_\_\_\_\_

Gas \_\_\_\_\_ Cu. Ft.

Dry Hole \_\_\_\_\_

Abandoned \_\_\_\_\_

Date

3/1 1925

M. A. BENEAR Scout