


Map No. Kansas Sec. 15 Twp. 23 R. 9 ✓Well No. 6 Teter Farm _____Skelly Company _____

NORTH

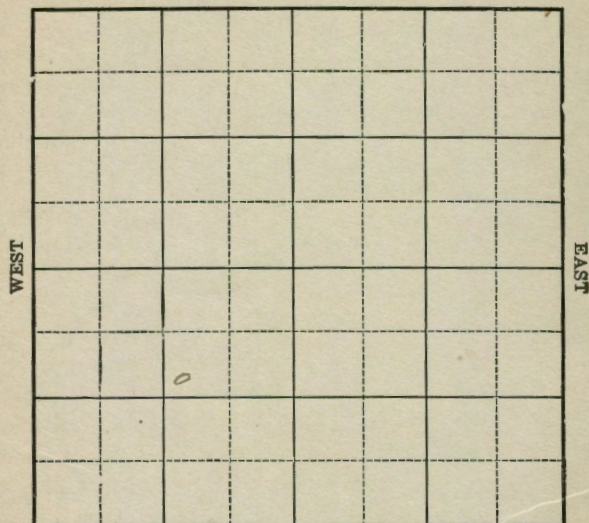

SOUTH

Location _____

Drilling Remarks _____

Rig Up _____

Drilling Remarks _____

RECORD

Cased _____ in. _____ ft.

Sand _____

Gas _____

Oil _____

Total Depth _____

PRODUCTION

1st 24 hrs. Nat. _____

1st. 24 hrs. after shot _____

Gas _____ cu. ft.

Dry Hole _____

Abandoned _____

Map No. Kansas Sec. 15 Twp. 23 R. 9Well No. 6 Teter Farm _____Skelly Company _____


NORTH

990 Ft. from N. Line

_____ Ft. from S. Line

990 Ft. from E. Line

_____ Ft. from W. Line

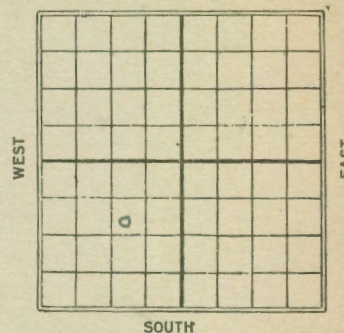

SOUTH

Date

REPORT

19253/1Rig up4/10Gas 2314-80 T.D. 2358Shot 140 lbs 125 Bbls

Map No. 15 Sec. 15 Twp. 23 R. 9EWell No. 6 Section
Kelly oil Co. Company

Contractor

COMPLETED

SECTION PLAT

990 Ft. from N. Line

Ft. from S. Line

990 Ft. from E. Line

Ft. from W. Line

Location

Rig up

Drilling and Remarks:

shot 140 gts
125 bls

RECORD

Cased in. ft.

Sand Pay 2364-58Gas 2314-80

Oil

Total Depth 2358

PRODUCTION

1st 24 hrs. Nat.

1st 24 hrs. after shot

Gas Cu. Ft.

Dry Hole

Abandoned

Date

APR 10 1925

192

Chas. L. Shaw
ScoutMap No. 15 Sec. 15 Twp. 23 R. 9Well No. 6 Section
Kelly Company

Contractor

FIRST REPORT

SECTION PLAT

990 Ft. from N. Line

Ft. from S. Line

990 Ft. from E. Line

Ft. from W. Line

Location

Rig up ✓

Drilling and Remarks:

RECORD

Cased in. ft.

Sand

Gas

Oil

Total Depth

PRODUCTION

1st 24 hrs. Nat.

1st 24 hrs. after shot

Gas Cu. Ft.

Dry Hole

Abandoned

Date

3/1 1925M. A. BENEAR

Scout