
DX 78-1

Greenwood KANSAS

Section 15 Township 23 Range 9E

Well No. #79 Teter Unit

Company C.S.O.

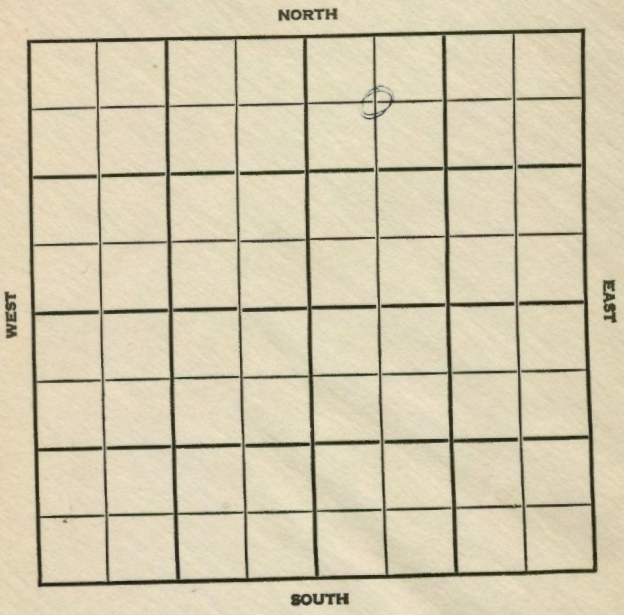

FORM 513 SUNRAY

County Greenwood Elev.

Sec. 15 Twp. 23 Rge. 9E

Company C. S. O.

Farm Name Teter Unit No. 79

TOPS	DEPTH	LOG	DATUM
Anh.			
Tp.			
H.			
Tr.	1222		
Dg.			
Bl.	1433		
L.	1689		
K.C.			
B.K.C.			
Ce. Btvl	2320		
C.			
M.			
M.			
K.			
Mz.			
Mc.			
V.			
S.			
S.			
A			
R.			
P€.			
G.			
TD	2386		

Loc. in Sec. C NW NE

Geol.

Contr.

Pool Teter

COMPLETE

FIRST REPORT

Date Comm.

7" @ 2347 w/125, CO 2374 PBTD, SD wait on wtr. flood. COMPLETE

Co. Lse. No. Sec. T. R.