


Greenwood **KANSAS**

SECTION 15 TOWNSHIP 23S RANGE 9E

WELL NO. #83 Teter Unit

COMPANY C.S.O.

NORTH C SE NW

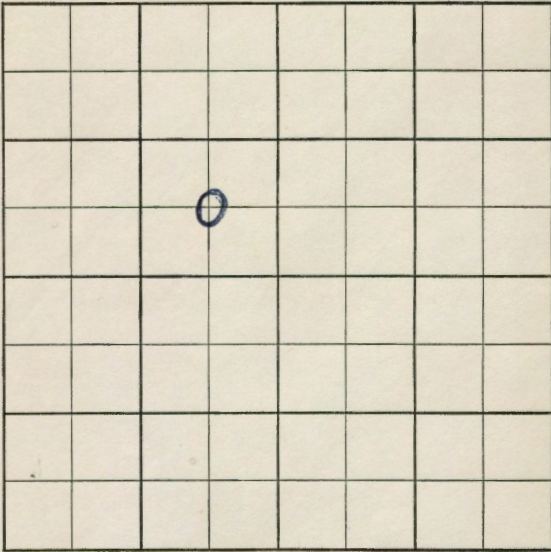

SOUTH

S-513-A

CO. Greenwood ELEV. 14100

SEC. 15 TWP. 23 RGE. 9E

COMPANY C.S.O. NO. 83

FIRST REPORT

JAN 8 '58

**COMPLETE**

FARM Teter Unit

LOC. C SE NW

Btvl Z 2373

Btvl S 2317

GEOL.

CONTR.

POOL Teter

SPUD

10" @ 204 w/100, 7" @  
2380, 36/2342-54, Frac,  
P 3 BO + 226 BW/24,

COMPLETE

RTD 2380

SE.

NO.

SEC.

TWP.

RGE.