


Map No. Kan Sec. 15 Twp. 23 R. 9
 Well No. 6 Green Farm
Skelly oil Company

Ft. from N. Line

530 Ft. from S. Line

990 Ft. from E. Line

Ft. from W. Line

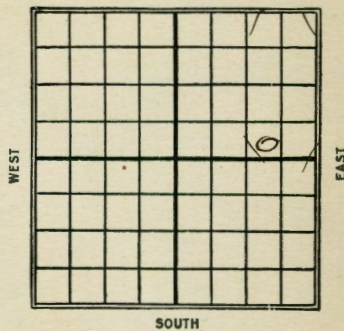


1926

Date

REPORT

9/5 Rig up
 9/27
 9/29 rigging up
 10/13 Drlg 890'
 10/27 Drlg 1475
 11/11 Sand 2303-2348

Map No. Greenwood Sec. 15 Twp. 23 R. 9
 Well No. 6 Green Farm
Skelly oil Company

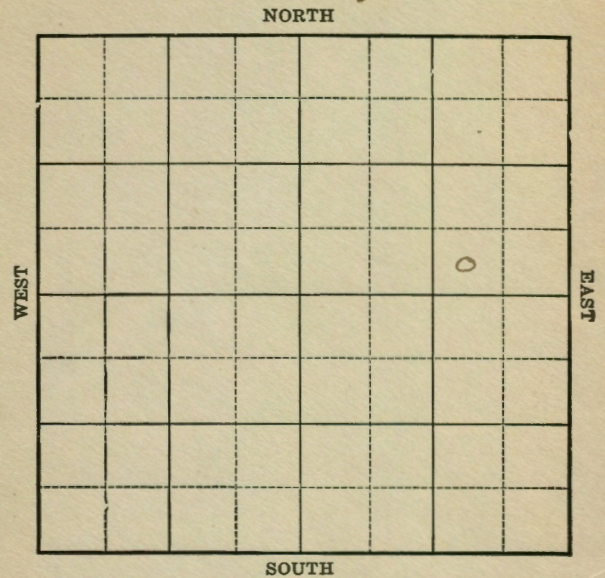

Location _____
 Drilling Remarks _____

Rig Up _____
 Drilling Remarks _____

RECORD

Cased _____ in. _____ ft.
 Sand _____
 Gas _____
 Oil _____
 Total Depth _____

PRODUCTION

1st 24 hrs. Nat. _____
 1st 24 hrs. after shot _____
 Gas _____ cu. ft.
 Dry Hole _____
 Abandoned _____

15 KANSAS
 Map No. Sec. 15 Twp. 23 R. 9
 Well No. 6 Blom Company
 Skelly Oil Co Contractor

COMPLETED

SECTION PLAT

			0

_____ Ft. from N. Line
 330 _____ Ft. from S. Line
 990 _____ Ft. from E. Line
 _____ Ft. from W. Line

Location _____
 Rig up _____
 Drilling and Remarks:

RECORD
 Cased _____ in., _____ ft.
 Sand 2303-2348
 Gas _____
 Oil _____
 Total Depth 2348

PRODUCTION
 1st 24 hrs. Nat. _____
 1st 24 hrs. after shot _____
 Gas _____ Cu. Ft.
 Dry Hole _____
 Abandoned _____

Date NOV 11 1926
 192 CHAS. L. SHERWOOD
 Scout

15 KANSAS
 Map No. Sec. 15 Twp. 23 R. 9
 Well No. 6 Blom Company
 Skelly Oil Co Contractor

FIRST REPORTS

SECTION PLAT

			0

_____ Ft. from N. Line
 330 _____ Ft. from S. Line
 990 _____ Ft. from E. Line
 _____ Ft. from W. Line

Location _____
 Rig up ✓
 Drilling and Remarks:

RECORD
 Cased _____ in., _____ ft.
 Sand _____
 Gas _____
 Oil _____
 Total Depth _____

PRODUCTION
 1st 24 hrs. Nat. _____
 1st 24 hrs. after shot _____
 Gas _____ Cu. Ft.
 Dry Hole _____
 Abandoned _____

Date SEP 15 1926
 192 CHAS. L. SHERWOOD
 Scout