


Map No. Kansas Sec. 15 Twp. 23 R. 9
 Well No. 6 Bradford-Liter Farm
Phillips Pet. Company

NORTH

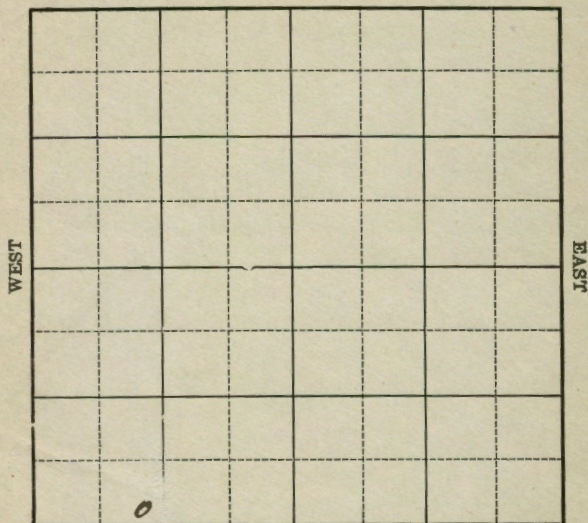

SOUTH

Location

Drilling Remarks

Rig Up

Drilling Remarks

RECORD

Cased _____ in. _____ ft.
 Sand _____
 Gas _____
 Oil _____
 Total Depth _____

PRODUCTION

1st 24 hrs. Nat. _____
 1st 24 hrs. after shot _____
 Gas _____ cu. ft.
 Dry Hole _____
 Abandoned _____


Map No. Kansas Sec. 15 Twp. 23 R. 9
 Well No. 6 Bradford-Liter Farm
Phillips Pet. Company

NORTH

_____ Ft. from N. Line

330 Ft. from S. Line

_____ Ft. from E. Line

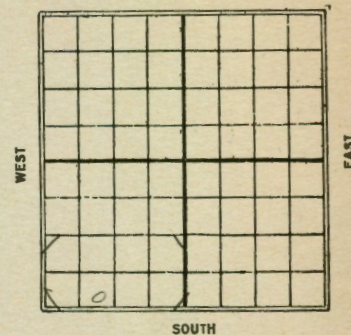990 Ft. from W. Line

Date

REPORT

1926
3/11 Location
3/18 _____
3/25 _____
4/1 _____
4/7 _____
4/14 _____
4/21 Bldg Rig
4/30 Rign
5/8 Dlg 875'
5/12 " 1470
5/19 " 2090'
7/26 Sand. 2315-6820.
 1407135 Oil

K15 KANSAS Sec. 15 Twp. 23 R. 9

Well No. 6 Bradford-Letter
Phillips Pet Co Company

Contractor

SECTION PLAT

Ft. from N. Line

330 Ft. from S. Line

Ft. from E. Line

990 Ft. from W. Line

FIRST REPORTS

Location ✓

Rig up

Drilling and Remarks:

RECORD

Cased in., ft.

Sand

Gas

Oil

Total Depth

PRODUCTION

1st 24 hrs. Nat.

1st 24 hrs. after shot

Gas Cu. Ft.

Dry Hole

Abandoned

Date

MAR 11 1926

CHAS. L. SHERWOOD

192 Scout

K15 KANSAS Sec. 15 Twp. 23 R. 9

Well No. 6 Bradford-Letter
Phillips Pet Co Company

Contractor

COMPLETED

SECTION PLAT

Ft. from N. Line

330 Ft. from S. Line

Ft. from E. Line

990 Ft. from W. Line

Location

Rig up

Drilling and Remarks:

RECORD

Cased in., ft.

Sand 2315-2368

Gas

Oil

Total Depth 2368

PRODUCTION

1st 24 hrs. Nat.

1st 24 hrs. after shot

Gas Cu. Ft.

Dry Hole

Abandoned

Date

MAY 26 1926

CHAS. L. SHERWOOD

192 Scout