


Greenwood Co, Kas.

Sec. 1 Twp. 24 Rge. 9
Farm ~~101~~ Carter No. 9446
Missouri Oil Company

Elev. T. D.

Log No. 9446

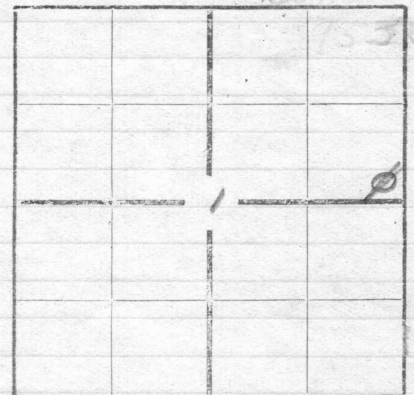

Soil-10
 li-30
 sh-50
 li-90
 sh-120
 li-170
 li-215
 sh-230
 li-250
 sh-290
 li-300
 sh-325
 li-345
 sh-370
 li-440
 sh-500
 li-515
 sh-540
 li-560
 sh-595
 li-615
 sh-630
 li-640
 sh-665
 li-690
 sh-720
 li-750
 sh-765
 li-775
 sh-795
 li-815
 sh-825
 li-850
 sh-880
 li-920
 sh-955
 li-970
 sh-975
 li-1005
 sh-1015
 li-1055
 sh-1065
 li-1075
 sh-1215
 li-1220
 sh-1230
 Road-1495
 sh-1620
 li-1730
 sh-1740
 li-1790
 sh-1905
 li-1915
 sh-1935
 li-1955
 sh-1980
 li-1985
 sh-2005
 li-2015
 sh-2025
 li-2030
 sh-2055
 li-2075
 sh-2175
 li-2185
 sh-2200
 li-2205
 sh-2255
 Road-2255
 Bottom Hole 2361