

Location. NEc NE


Sec. 35 T. 24 R. 10E.

Casing Record.

County. Greenwood.

35-24-10E

10" 1049 Farm. John B. Greives. No. 1
 20" 6 1/2" 1547 Company. York State Oil Co. Inc.
 15 1/8" 65/8" Corvett. N. Spencer.
 12 1/2" 576 53/16" Corvett. 5-14-32 Comp. 6-10-32
 Total Depth 2000 Shot Quarts Between.
 Correspondence Regarding This Well Should Be Referred To.

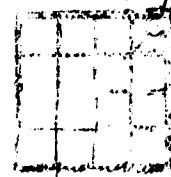

JUL 16 1932

Figures Indicate Bottom of Formations.

Elevation.
Initial Production.

Date Issued. 7-16-32

Dry.

Formation	Depth	Formation	Depth.
cellar	3	shale	1100
clay	15	lime	1200
shale	20	shale	1340
sand	30	lime	1350
shale	100	shale	1360
sand	140	lime	1370
shale	160	red rock	1375
lime	166	lime	1405
shale	180	sand	1420
lime	190	lime	1447
shale	255	shale	1450
lime	275	lime	1470
shale	330	shale	1475
lime	395	lime	1480
shale	420	shale	1485
lime	440	lime	1497
shale	450	shale	1515
lime	455	lime	1519
shale	460	shale	1650
lime	470	lime	1655
shale	490	shale	1670
lime	500	lime	1680
shale	510	shale	1735
lime	515	lime	1755
shale	525	shale	1775
lime	530	lime	1785
shale	570	lime shells	1795
lime	580	shale	1802
shale	600	lime	1807
lime	605	shale	1846
shale	645	lime	1850
lime	655	sdv shale	1890
shale	670	shale blk	1897
lime	745	shale light	1932
shale	760	shale blk	1944
lime	765	sdv shale	1964
shale	912	shale dark	1976
lime	920	shale blk	1993
sdv lime ✓	930	S.L.M.	2000
sand	970		
shale	975		
lime	980		
sdv shale	995		
sand	1035		
sdv shale	1049		
lime	1095		

T.D.


Greenwood

Form 51-5M-2-29-34703

Map No. **KANSAS** Sec. 35 Twp. 24 R. 10^E

Well No. 1-Greves Farm _____
York State Oil Company

NORTH

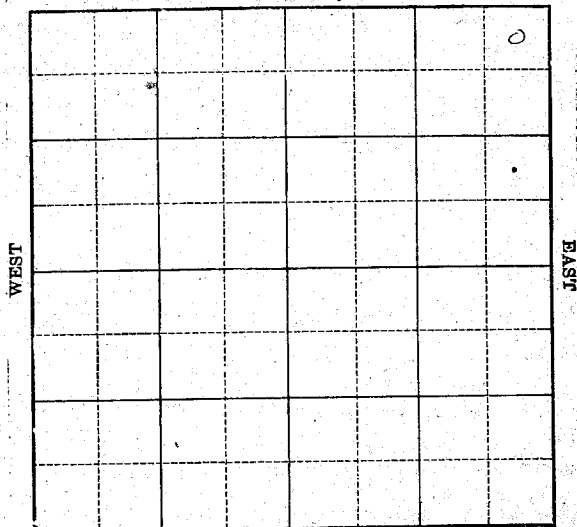

SOUTH

Location _____
Drilling Remarks _____

Rig Up _____
Drilling Remarks _____

RECORD

Cased _____ in. _____ ft.
Sand _____
Gas _____
Oil _____
Total Depth _____

PRODUCTION

1st 24 hrs. Nat. _____
1st 24 hrs. after shot _____
Gas _____ cu. ft.
Dry Hole _____
Abandoned _____


Greenwood

FORM 252A-5M-5-30-PETROL

Map No. **KANSAS** Sec. 35 Twp. 24 R. 10^E

Well No. 1-Greves Farm _____
York State Oil Company

NORTH

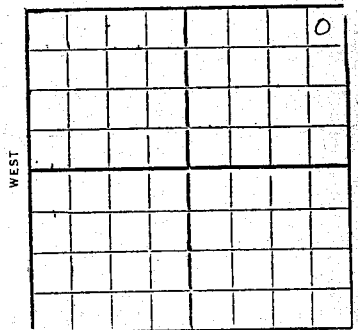

SOUTH

330 Ft. from N. Line

_____ Ft. from S. Line

330 Ft. from E. Line

_____ Ft. from W. Line

1932

REPORT

Date

5/11

5/18

5/25

6/1

6/8

6/15

6/22

Loc

Spdg

Drig 500'

" 1045

8"-1525

Drig 1600'

510 2000'

TD 2000

No sand

Dry & Abandon

16 KANSAS

Map No. Sec. 35 Twp. 24 R. 10 E

Well No. 1 Greves

York State Oil Co. Company

Contractor

FIRST REPORTS

330 Ft. from N. Line

Ft. from S. Line

330 Ft. from E. Line

Ft. from W. Line

SECTION PLAT

Location ✓

Rig up

Drilling and Remarks:

RECORD

Cased in, ft.

Sand

Gas

Oil

Total Depth

PRODUCTION

1st 24 hrs. Nat.

1st 24 hrs. after shot

Gas Cu. Ft.

Dry Hole

Abandoned

Date

MAY 1 1 1932 CHAS. L. SHERWOOD

192

Scout

16 KANSAS

Map No. Sec. 35 Twp. 24 R. 10 E

Well No. 1 Greves

York State Oil Co. Company

Contractor

COMPLETED

330 Ft. from N. Line

Ft. from S. Line

330 Ft. from E. Line

Ft. from W. Line

SECTION PLAT

ABANDONED

Location

Rig up

Drilling and Remarks:

no sand

RECORD

Cased in, ft.

Sand

Gas

Oil

Total Depth 7000

PRODUCTION

1st 24 hrs. Nat.

1st 24 hrs. after shot

Gas Cu. Ft.

Dry Hole

Abandoned

Date

JUN 2 2 1932 CHAS. L. SHERWOOD

192

Scout