

Plotted
J. R. S.

WELL LOG BUREAU - KANSAS GEOLOGICAL SOCIETY

UNION NATIONAL BANK BLDG, WICHITA, KANSAS

Location SE NE SE.

Sec. 35 T. 24 R. 10E.

Casing Record

20" 10"
15 1/2" 8 1/4"
12 3/8" 65/8"
12 3/8" 53/16"

Farm- Levi Wilcox

No. 1

Company- Independent Oil & Gas Co.

Contr.-

Comm.- 5/28/1930.

Comp.- 6/16/30

Total Depth 2056'.


Shot

Quarts Between

Correspondence Regarding This Well Should Be Referred to

County- Greenwood.

JUN 30 1930

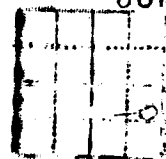

Figures Indicate Bottom of Formations.


Date Issued. 6/28/1930.

Elevation

Initial Production Dry

Formation	Depth	Formation	Depth
lime white hrd	15	lime white hrd	1480
slate white hrd	45	shale black sft	1485
slate black sft	85	lime white hrd	1505
lime white hrd	95	shale white sft	1520
slate black sft	125	lime white hrd	1530
lime white hrd	135	shale white sft	1582
slate white sft	170	shale white sft	1587
lime white hrd	185	shale gray sft	1640
slate white sft	250	lime gray hrd	1650
slate & lime	270	shale gray sft	1657
lime drk hrd	280	lime white hrd	1675
slate shells sft & hrd	295	slate white sft	1690
shale gray sft	330	shale white sft	1730
lime white hrd	375	slate shl. drk H&S	1850
slate white sft	390	shells drk H&S	1853
lime drk hrd	405	shale drk H&S	1860
slate black sft	425	sdv shale Hrd & sft	1863
lime lgt hrd	435	sdv shale	1897
slate lgt hrd	445	lime white hrd	1902
shale shells S. & H.	475	sdv shale	1937
lime white hrd	500	slate black sft	1943
slate white sft	510	lime white hrd	1956
slate shells sft	555	slate white sft	1964
slate white sft	570	slate black sft	1996
lime white hrd	580	slate gray sft	2003
slate white sft	601	shale gray sft	2023
slate black sft	650	lime gray hrd	2033
lime white hrd	705	shale black sft	2043
slate black sft	725	shale gray sft	2056
lime white hrd	740		
slate white sft	853	Total Depth	2056'
slate gray sft	940		
sand drk sft	975		
sdv shale drk & sft	986		
HFV at 945'			
sdv shale drk & sft	1010		
water sand drk & sft	1025		
Hole full of salt wtr	1015'		
sdv shale drk & sft	1045		
lime white hrd	1050		
slate blue sft	1070		
lime drk hrd	1095		
slate drk sft	1098		
lime white hrd	1185		
shale white sft	1200		
shale drk sft	1310		
shale drk sft	1345		
lime gray med	1380		
red rock red sft	1385		
lime white S & H	1435		
1 1/2 BW per hr 1430'			
lime white hrd	1450		
shale black sft	1458'		

Greenwood
 Form 51-5M-2-29-34703
 Map No. **KANSAS** Sec. 35 Twp. 24 R. 10
 Well No. 1- Milcox Farm
Independent Oil & Gas Company

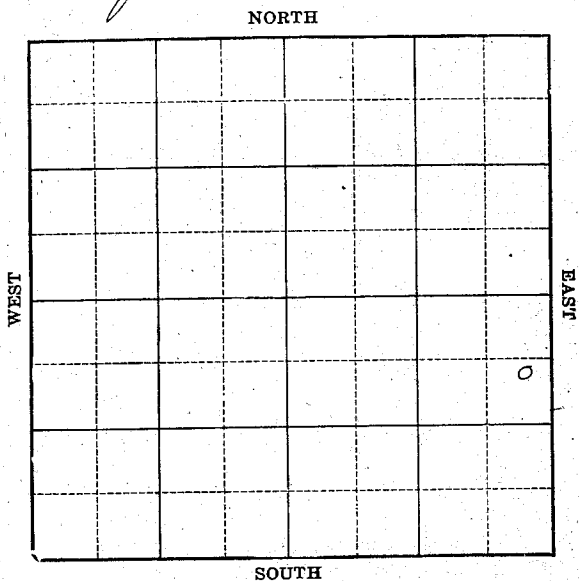

Location
 Drilling Remarks

Rig Up
 Drilling Remarks


RECORD

PRODUCTION

Cased _____ in. _____ ft.
 Sand _____
 Gas _____
 Oil _____
 Total Depth _____

1st 24 hrs. Nat. _____
 1st 24 hrs. after shot _____
 Gas _____ cu. ft.
 Dry Hole _____
 Abandoned _____

Greenwood
 Form 252A-5M-11-29-38055
 Map No. **KANSAS** Sec. 35 Twp. 24 R. 10
 Well No. 1- Milcox Farm
Independent Oil & Gas Company

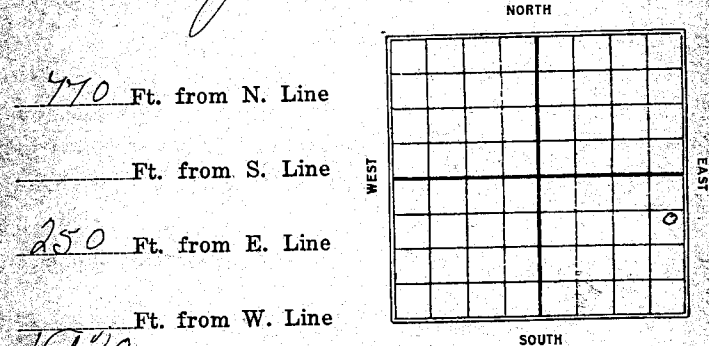

Date _____ REPORT
5/28 Spdy
6/4 Drilling 520'
6/11 1165'
6/18 Broken sand from
1892-1937
TO 2057
Dry & Abandon

Greenwood
 Map No. KANSAS Sec. 35 Twp. 24 R. 10 ^E
 Well No. 1 *Wilcox*
Independent Oil Co. Company
 Contractor

FIRST REPORTS

770 Ft. from N. Line
 _____ Ft. from S. Line
750 Ft. from E. Line
 _____ Ft. from W. Line

SECTION PLAT

			0

Location _____
 Rig up _____
 Drilling and Remarks:

dry

RECORD

Cased _____ in., _____ ft.
 Sand _____
 Gas _____
 Oil _____
 Total Depth _____

PRODUCTION

1st 24 hrs. Nat. _____
 1st 24 hrs. after shot _____
 Gas _____ Cu. Ft.
 Dry Hole _____
 Abandoned _____

Date

MAY 28 1930

19 CHAS. L. SHERWOOD Scout

Greenwood
 Map No. KANSAS Sec. 35 Twp. 24 R. 10 ^E
 Well No. 1 *Wilcox*
Independent Oil Co. Company
 Contractor

SECTION PLAT

			0

770 Ft. from N. Line
 _____ Ft. from S. Line
250 Ft. from E. Line
 _____ Ft. from W. Line

ABANDONED

Location _____
 Rig up _____
 Drilling and Remarks:

Baken Ltd.
1892-1937

RECORD

Cased _____ in., _____ ft.
 Sand _____
 Gas _____
 Oil _____
 Total Depth 2007

PRODUCTION

1st 24 hrs. Nat. _____
 1st 24 hrs. after shot _____
 Gas _____ Cu. Ft.
 Dry Hole ☒
 Abandoned ☒

Date

JUN 18 1930

19 CHAS. L. SHERWOOD Scout