


26540

#9-

comm 3-11-24  
 covf -4-8-24  
 find-150 bbls.

12- 61  
 10 1304'1"  
 8 1762'8"  
 6 1703'4527

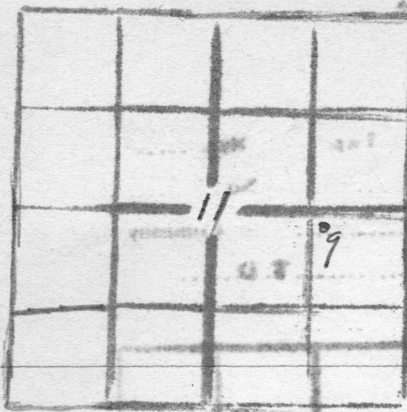

sur 0-5

L hd 10

sh bl 40

L hf 85

sl sf 115

L hd 124

sh et 170

L hd 250

L sf 255

sl dk sf 265

sl dk 290

L hd 298

L dk sf 315

L hd 322

sl sf 370

L whhd 380

sl sf 400

L hd 415

sl 475

L hd 480

sl sf 495

L hd 515

sl 565

L hd 570

sl sf 618

L wh 645

sl et 668

L hd 688

sl sf 694

sl wh 720

L wh 726

sl 11 sf 776

L 11 hd 791

sl 11 800

L hd  
sl815  
856

L hd

864

sh sf

900

L et

910

sl

930

L hd

960

sh sf

966

L whhd

971

sh sf

978

L med

1000

sh wh sf

1045

L hd

1055

sh sf

1100

L 11

1110

sh et

1167

S wh

1192 HFW

sl L

1202

sh wh

1250

sh bl

1315

Key L

1410

sl L

1415 with

Key L

1440

L whhd

1454

sl bl

1590 HFW

oswer hd

1698

sl

1705

L hd

1730

sh bl

1735

sl wh

1820

sh bl

1900

L wh

1950

sl

2000

L whhd

2005

sl 11 sf

2025

L 11 hd

2035

sh 11 sf

2210

sl 11 11

2244

sl bl sf

2294  
2300 TID.