

County **Woodson** State **Kansas**
 Sec. **5** (Bk. **24**) (Sur. **15E**) Map No.
 Operator **True Ashlock et al.**
 Well No. **1** Farm **Marion**
 Elev. Location **NW NW NE**
330 Ft. From **N** Line **NE**
330 Ft. From **W** Line Quarter
 Ist. Report **MAR 26 1952**
 Completion
 Remarks
 Spudding Date
 Drlg. Data **Wildcat**
CT Miss 1509 4" @ 1530 TD 1542 / oil,
no test

J. G. McGEHEE


County **Woodson** State **Kansas**
 Sec. **5** (Bk. **24**) (Sur. **15E**) Map No.
 Operator **True Ashlock et al.**
 Well No. **1** Farm **Marion**
 Elev. Location **NW NW NE**
330 Ft. From **N** Line **NE**
330 Ft. From **W** Line Quarter
 Ist. Report
 Completion **APR 2 1952**
 Remarks **Wildcat**
 Spudding Date
 Drlg. Data **Oil well TD 1542**
Miss. 1509 4" @ 1530 TD 1542
Comp. 35 bopd

J. G. McGEHEE

COMPLETED

1952
 3/26 CT Miss 1509
 4" @ 1530 TD 1542
 F oil, no test
 Oil Well TD 1542
 Miss. 1509' 4" @ 1530
 TD 1542 Comp. 35 bopd

REPORT

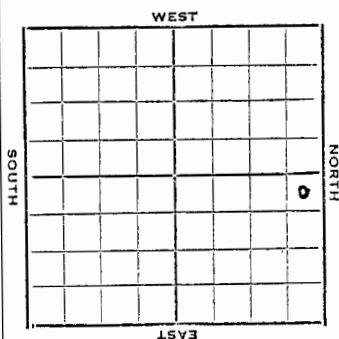

FORM 252-B
 10M S-51 TPCO.
 Sec. **5** Twp. **24** R. **15E**
 Well No. **#1 Marion** Farm
 True Ashlock et al
 Contractor
 Company