E 1/2 S

10 Range

24 Township

16 Section

Greenwood County

Matthews Farm No. 1

Company

Sec.

	o		

Twp.

6	5	4	3	2	1
7	8	9	10	11	12
18	17	X	15	14	13
19	20	21	22	23	24
30	29	28	27	26	25
31	32	33	34	35	36

Elev. _____ T.D. 2312'

Date Drilled 9-16-26

Correlation by _____
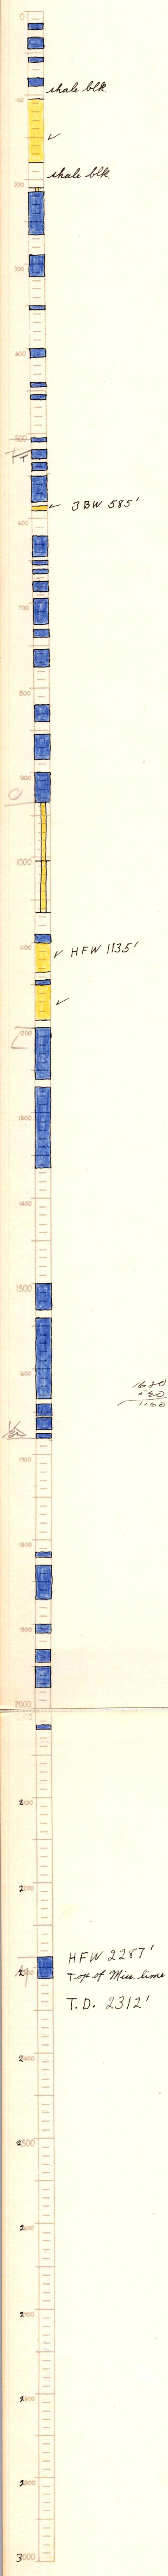
Prod.