

4-24-22E

SIDE ONE

STATE CORPORATION COMMISSION OF KANSAS
OIL & GAS CONSERVATION DIVISION

ALL COMPLETION OR RECOMPLETION FORM
ACO-1 WELL HISTORY

DESCRIPTION OF WELL AND LEASE

Operator: license # 9218
name D. L. Stokes
address Rt. 1, Box 24L

City/State/Zip LaCygne, Ks. 66040

Operator Contact Person D. L. Stokes
Phone 913/757-2442

Contractor: license # 9605
name Rusty's Drilling

Wellsite Geologist None
Phone

PURCHASER Eureka Crude Purchasing

Designate Type of Completion

- ☒ New Well ☐ Re-Entry ☐ Workover
- ☒ Oil ☐ SWD ☐ Temp Abd
☐ Gas ☐ Inj ☐ Delayed Comp.
☐ Dr ☐ Other (Core, Water Supply etc.)

If OWWO: old well info as follows:

Operator
Well Name
Comp. Date Old Total Depth

WELL HISTORY

Drilling Method: ☐ Mud Rotary ☒ Air Rotary ☐ Cable

7/15/84 7/17/84 7/20/84
Spud Date Reached TD Completion Date

720' 702'
Total Depth PBDT

Amo f Surface Pipe Set and Cemented at 20 feet

Multiple Stage Cementing Collar Used? ☐ Yes ☒ No

If Yes, Show Depth Set feet

alternate 2 completion, cement circulated
from 720' feet depth to surface w/ 120 SX cmt

API NO. 15 - 011-22,283

County Bourbon

SW NW SW Sec 4 Twp 24 Rge 22
(location)

1485 Ft North from Southeast Corner of Section
4815 Ft West from Southeast Corner of Section
(Note: locate well in section plat below)


Lease Name Kaycee Well# 3

Field Name NA

Producing Formation Bartlesville

Elevation: Ground NA KB NA

Section Plat

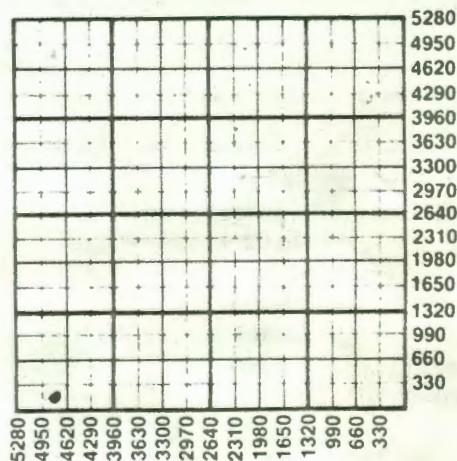

WATER SUPPLY INFORMATION

Source of Water: Air Drilled

Division of Water Resources Permit #

☐ Groundwater. Ft North From Southeast Corner and
(Well) Ft West From Southeast Corner of
Sec Twp Rge ☐ East ☐ West

☐ Surface Water. Ft North From Southeast Corner and
(Stream, Pond etc.) Ft West From Southeast Corner
Sec Twp Rge ☐ East ☐ West

☐ Other (explain)
(purchased from city, R.W.D.#)

Disposition of Produced Water: ☒ Disposal
☐ Repressuring

Docket #

INSTRUCTIONS: This form shall be completed in duplicate and filed with the Kansas Corporation Commission, 200 Colorado Derby Building, Wichita, Kansas 67202, within 90 days after completion or recompletion of any well. Rules 82-3-130 and 82-3-107 apply.

Information on side two of this form will be held confidential for a period of 12 months if requested in writing and submitted with the form. See rule 82-3-107 for confidentiality in excess of 12 months.

366-48-11

535939

SIDE TWO

Operator Name D. L. Stokes Lease Name Kaycee Well# 3 SEC 4 TWP. 24 RGE. 22 ☒ East ☐ West

WELL LOG

INSTRUCTIONS: Show important tops and base of formations penetrated. Detail all cores. Report all drill stem tests giving interval tested, time tool open and closed, flowing and shut-in pressures, whether shut-in pressure reached static level, hydrostatic pressures, bottom hole temperature, fluid recovery, and flow rates if gas to surface during test. Attach extra sheet if more space is needed. Attach copy of log.

Drill Stem Tests Taken
Samples Sent to Geological Survey
Cores Taken

☐ Yes ☒ No
☐ Yes ☒ No
☒ Yes ☐ No

Formation Description
☐ Log ☒ Sample

Name	Top	Bottom
Ft. Scott Lime	320'	350'
Bartlesville Sand	594'	720'

620' - 635'

TUBING RECORD size <u>1"</u> set at <u>610'</u> packer at <u>none</u>		Liner Run ☐ Yes ☒ No	
Date of First Production <u>7/21/84</u>	Producing method ☐ flowing ☒ pumping ☐ gas lift ☐ Other (explain)		
Estimated Production Per 24 Hours	Oil	Gas	Water
	<u>2</u> Bbls	<u>TSTM</u> MCF	<u>1/4</u> Bbls
	Gas-Oil Ratio		Gravity
	<u>TSTM</u> CFPB		<u>29</u>

Disposition of gas: ☐ vented
☐ sold
☐ used on lease

METHOD OF COMPLETION

☐ open hole ☒ perforation
☐ other (specify)

☐ Dually Completed.
☐ Commingled

PRODUCTION INTERVAL

620' - 630'

CASING RECORD ☒ new ☐ used							
Report all strings set - conductor, surface, intermediate, production, etc.							
Purpose of string	size hole drilled	size casing set (in O.D.)	weight lbs/ft.	setting depth	type of cement	# sacks used	type and percent additives
Surface	9"	7.5/8"	26#	20'	Class C	5	None
Production Csg	6"	2.7/8"	6.5#	700'	50/50 PQZ	120	2% gel
PERFORATION RECORD				Acid, Fracture, Shot, Cement Squeeze Record			
shots per foot	specify footage of each interval perforated			(amount and kind of material used)		Depth	
2	620' - 630'			6000# sand - 130 bbls water		620' - 630'	