

15-011-20244

State Geological Survey
WICHITA BRANCH
KANSAS DRILLERS LOG

S. 12 T. 24 R. 22 E

Loc. C NE SW SW

County Bourbon

API No. 15 — 011 — 20296
County Number

Operator
Gator Oil Co.

Address
Box 1628 Lake Worth, Florida 3340


Well No. 8 Lease Name Nelson

Footage Location
feet from (N) (S) line feet from (E) (W) line

Principal Contractor Nance Drilling Co. Geologist Jay Robertson

Spud Date 2-1-77 Total Depth 747' P.B.T.D.

Date Completed 2-2-77 Oil Purchaser

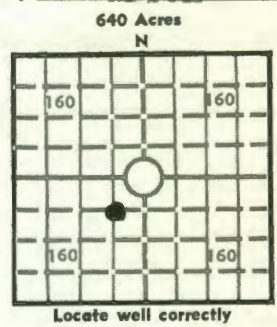

Elev.: Gr. _____

DF _____ KB _____

CASING RECORD

Report of all strings set — surface, intermediate, production, etc.

Purpose of string	Size hole drilled	Size casing set (in O.D.)	Weight lbs/ft.	Setting depth	Type cement	Sacks	Type and percent additives
Overburden	9"	6 5/8" O.D.	13	44'			
Production	6 1/8	2 7/8	6.4	623		50	

LINER RECORD

PERFORATION RECORD

Top, ft.	Bottom, ft.	Sacks cement	Shots per ft.	Size & type	Depth interval
			1		569-579

TUBING RECORD

Size	Setting depth	Packer set at

ACID, FRACTURE, SHOT, CEMENT SQUEEZE RECORD

Amount and kind of material used	Depth interval treated
Awaiting Treatment'	

INITIAL PRODUCTION

Date of first production		Producing method (flowing, pumping, gas lift, etc.)			
RATE OF PRODUCTION PER 24 HOURS	Oil	Gas	Water	Gas-oil ratio	
	bbis.	MCF	bbis.	CFPB	
Disposition of gas (vented, used on lease or sold)			Producing interval(s)		

INSTRUCTIONS: As provided in KCC Rule 82-2-125, within 90 days after completion of a well, one completed copy of this Drillers Log shall be transmitted to the State Geological Survey of Kansas, 4150 Monroe Street, Wichita, Kansas 67209. Copies of this form are available from the Conservation Division, State Corporation Commission, 3830 So. Meridian (P.O. Box 17027), Wichita, Kansas 66217. Phone AC 316-522-2206. If confidential custody is desired, please note Rule 82-2-125. Drillers Logs will be on open file in the Oil and Gas Division, State Geological Survey of Kansas, Lawrence, Kansas 66044.

Operator Gator Oil Co. DESIGNATE TYPE OF COMP.: OIL, GAS,
 DRY HOLE, SWDOW ETC.: GAS

Well No. 8 Lease Name Nelson

S 12T 24R 22^E


WELL LOG

Show all important zones of porosity and contents thereof; cored intervals, and all drill-stem tests, including depth interval tested, cushion used, time tool open, flowing and shut-in pressures, and recoveries.

SHOW GEOLOGICAL MARKERS, LOGS RUN, OR OTHER DESCRIPTIVE INFORMATION.

FORMATION DESCRIPTION, CONTENTS, ETC.	TOP	BOTTOM	NAME	DEPTH
Overburden	0	10		
Grey Shale	10	38		
Grey Lime	38	45		
Light Grey Shale	45	75		
Grey Shale	75	132		
Green Shale	132	137		
Brown Lime	137	155		
Black Shale	155	158		
Grey Shale	158	202		
Brown Lime	202	208		
Grey Shale	208	218		
Brown Lime	218	227		
Black Shale	227	235		
Brown Lime	235	240		
Dark Grey Shale	240	405		
Grey Shale	405	425		
Grey Shale	425	450		
Dark Grey Shale	450	578		
		578	Top Of Miss.	
Grey Lime & Chert	578	620		
Brown Lime	620	630		
Grey Lime & Chert	630	747		
		747	T.D.	

USE ADDITIONAL SHEETS, IF NECESSARY, TO COMPLETE WELL RECORD.

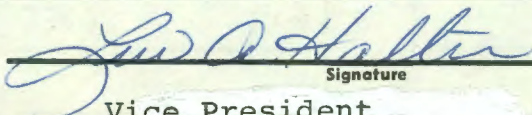Date Received	 Signature
	Vice President Title
	6-28-77 Date