18-24-22 Plotted: 10/1/25 L.R.

Plotted

Sec. 18 Twp. 24 Range. 22 .....Bourbon..... County

Index. 22:18

Plotted 10/1/25 L.R.

Company Bourbonola Oil & Gas Co. Farm Eagar #5

Well No. 18-24-22

Commenced March 10, 1920 Completed March 16, 1920

Elevation Total Depth 776

Initial Production .....bbls. Vol. .....cu. ft.

Remarks. Grant colby contractor
Log furnished by J. R. Cline, 802 N. Jefferson, Iola, Ks.

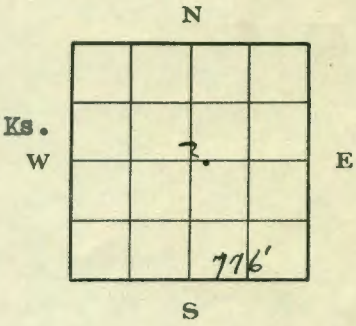

Casing record

8¼ in drive pipe 17 ft.
Packer set at 560 ft.
2 inch tubing 778
Top of producing sand 614
Bottom of producing sand 634

Plotted

Soil	5	5
Lime shells	15	20
Shale	5	25
Lime	15	40
Shale	5	45
Lime hard	55	100
Shale	140	240
Lime	15	255
Shale	10	265
Lime	5	270
Shale	60	330
Lime	30	360
Shale	40	400
Lime	15	415
Shale	10	425
Lime	5	430
Shale	184	614
Gas sand	20	634
Shale	71	705
Broken sand	10	715
Sandy shale	5	720
Shale	53	773
Black slate	2	775
Mississippian lime	1	776