

JUN 10 1987

KANSAS GEOLOGICAL SURVEY
WICHITA BRANCH

SIDE ONE

19-24-2LE



STATE CORPORATION COMMISSION OF KANSAS
OIL & GAS CONSERVATION DIVISION
WELL COMPLETION OR RECOMPLETION FORM
ACO-1 WELL HISTORY
DESCRIPTION OF WELL AND LEASE

Operator: License # 5375
Name HILLENBURG OIL COMPANY
Address P. O. Box 94
City/State/Zip Bronson, Kansas 66716

Purchaser

Operator Contact Person John L. Curtis
Phone (316) 939-4322

Contractor: License # 5868
Name Lewis Drilling

Wellsite Geologist
Phone

Designate Type of Completion
☒ New Well ☐ Re-Entry ☐ Workover
☐ Oil ☐ SWD ☐ Temp Abd
☐ Gas ☐ Inj ☐ Delayed Comp.
☒ Dry ☐ Other (Core, Water Supply etc.)

If ONWO: old well info as follows:
Operator
Well Name
Comp. Date Old Total Depth

WELL HISTORY

Drilling Method:
☒ Mud Rotary ☐ Air Rotary ☐ Cable
5/18/87 5/19/87 5/19/87
Spud Date Date Reached TD Completion Date
702' NA
Total Depth PBTD

Amount of Surface Pipe Set and Cemented at 20 feet
Multiple Stage Cementing Collar Used? Yes ☒ No
If yes, show depth set feet
If alternate 2 completion, cement circulated
from feet depth to w/ SX cmt
Cement Company Name
Invoice #

API NO. 15-011-22,579

County BOURBON

NW NE SW/4 19 24 22 X East
Sec Twp Rge West

2540 Ft North from Southeast Corner of Section
3780 Ft West from Southeast Corner of Section
(Note: Locate well in section plat below)


Lease Name Thompson Unit Well # 40-87

Field Name Bronson - Xenia

Producing Formation

Elevation: Ground KB

Section Plat

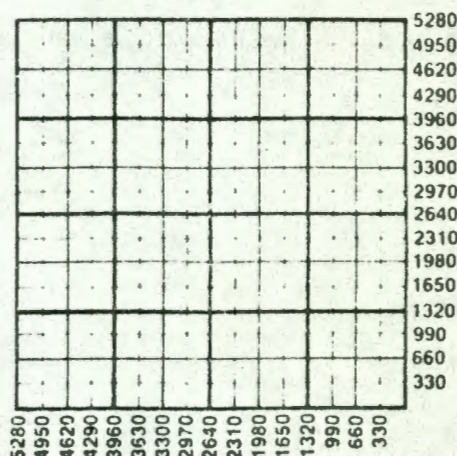

X WATER SUPPLY INFORMATION

Disposition of Produced Water: Disposal
Docket # Repressuring

Questions on this portion of the ACO-1 call:

Water Resources Board (913) 296-3717

Source of Water:
Division of Water Resources Permit #

Groundwater Ft North from Southeast Corner
(Well) Ft West from Southeast Corner of
Sec Twp Rge East West

Surface Water Ft North from Southeast Corner
(Stream, pond etc) Ft West from Southeast Corner
Sec Twp Rge East West

Other (explain)
(purchased from city, R.W.D. #)

INSTRUCTIONS: This form shall be completed in triplicate and filed with the Kansas Corporation Commission, 200 Colorado Derby Building, Wichita, Kansas 67202, within 120 days of the spud date of any well. Rule 82-3-130, 82-3-107 and 82-3-106 apply.
Information on side two of this form will be held confidential for a period of 12 months if requested in writing and submitted with the form. See rule 82-3-107 for confidentiality in excess of 12 months.

311-44-21

SIDE TWO

536259

Operator Name HILLENBURG OIL COMPANY Lease Name..... Thompson Unit Well #..... 40-87

Sec....19.... Twp.24..... Rge.22..... ☒ East ☐ West County..... BOURBON

WELL LOG

INSTRUCTIONS: Show important tops and base of formations penetrated. Detail all cores. Report all drill stem tests giving interval tested, time tool open and closed, flowing and shut-in pressures, whether shut-in pressure reached static level, hydrostatic pressures, bottom hole temperature, fluid recovery, and flow rates if gas to surface during test. Attach extra sheet if more space is needed. Attach copy of log.

Drill Stem Tests Taken ☐ Yes ☒ No
Samples Sent to Geological Survey ☐ Yes ☒ No
Cores Taken ☐ Yes ☒ No

Formation Description
☒ Log ☐ Sample

596 - 614 - Bartlesville Sand - light show,
good odor.

Name	Top	Bottom
Fort Scott Lime	402	407
Ardmore Lime	407	411
Bartlesville	596	614

CASING RECORD ☐ New ☐ Used

Report all strings set-conductor, surface, intermediate, production, etc.

Purpose of String	Size Hole Drilled	Size Casing Set (in O.D.)	Weight Lbs./Ft.	Setting Depth	Type of Cement	#Sacks Used	Type and Percent Additives
..... Surface		 6 5/8"		 20'	 Portland	 5	

PERFORATION RECORD

Acid, Fracture, Shot, Cement Squeeze Record

Shots Per Foot	Specify Footage of Each Interval Perforated	(Amount and Kind of Material Used)	Depth
.....			
.....			
.....			
.....			

TUBING RECORD	Size	Set At	Packer at	Liner Run	☐ Yes ☐ No
---------------	------	--------	-----------	-----------	--

Date of First Production | Producing Method
☐ Flowing ☐ Pumping ☐ Gas Lift ☐ Other (explain).....