

KANSAS



State Geological Survey
WICHITA BRANCH

And

WELL COMPLETION REPORT AND
DRILLER'S LOG

S. 27 T. 24 R. 22 E
W

Loc. ~~NE 1/4~~ N2 NE NE
KCC

API No. 15 — 011 — 21151
County Number

County Bourbon

Operator
Reese Exploration, Inc.

RELEASED


Address
P.O. Box 11598, K.C. Mo. 64138

Date: JUN 7 1982

Well No. 20-81 Lease Name Mix

FROM CONFIDENTIAL

Footage Location 380 4 570 FSL 380 FEL 710
feet from (N) (S) line feet from (E) (W) line

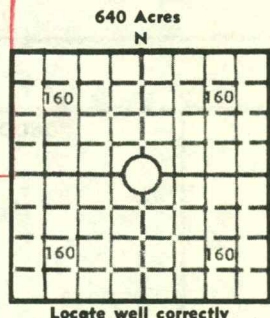

Elev.: Gr. _____

Principal Contractor
Michael Drilling, Inc.

Geologist

Spud Date
4-24-81

Date Completed
4-25-81

Total Depth
513

P.B.T.D.

Directional Deviation

Oil and/or Gas Purchaser
Maclaskey

DF _____ KB _____

CASING RECORD

Report of all strings set — surface, intermediate, production, etc.

Purpose of string	Size hole drilled	Size casing set (in O.D.)	Weight lbs/ft.	Setting depth	Type cement	Sacks	Type and percent additives
Surface	8-7/8	6-1/4	17#	40	Portland	4	none
2"	5-1/4	2-3/8	4#	523	"	90	2% Gel

LINER RECORD

PERFORATION RECORD

Top, ft.	Bottom, ft.	Sacks cement	Shots per ft.	Size & type	Depth interval
none					

Size	Setting depth	Packer set at
none		

ACID, FRACTURE, SHOT, CEMENT SQUEEZE RECORD

Amount and kind of material used	Depth interval treated
Frac - Gelled Water - 60 sacks sand	

INITIAL PRODUCTION

Date of first production May 1981	Producing method (flowing, pumping, gas lift, etc.) Pumping
RATE OF PRODUCTION PER 24 HOURS	Oil 1 bbls. Gas 0 MCF Water 0 bbls. Gas-oil ratio CFPB
Disposition of gas (vented, used on lease or sold)	Producing interval (s)

INSTRUCTIONS: As provided in KCC Rule 82-2-125, within 90 days after completion of a well, one completed copy of this Drillers Log shall be trans-
mitted to the State Geological Survey of Kansas, 4150 Monroe Street, Wichita, Kansas 67209. Copies of this form are available from the Conservation
Division, State Corporation Commission, 245 No. Water, Wichita, Kansas 67202. Phone AC 316-522-2206. If confidential custody is desired, please note
Rule 82-2-125. Drillers Logs will be on open file in the Oil and Gas Division, State Geological Survey of Kansas, Lawrence, Kansas 66044.

53635

Date Received _____

Signature *Barry ...*

Title Bookkeeper

Date June 5, 1981

USE ADDITIONAL SHEETS, IF NECESSARY, TO COMPLETE WELL RECORD.

DEPTH	NAME	BOTTOM	TOP	FORMATION DESCRIPTION, CONTENTS, ETC.
5			0	Soil and clay
23			5	lime
28			23	shale
30			28	lime
30			30	shale
38			38	lime
64			64	shale
68			68	lime
72			72	shale
83			83	lime
97			97	shale
261			261	lime
269			269	shale
354			354	lime
380			380	shale
424			424	lime
439			439	shale
447			447	lime
450			450	shale
454			454	sandy shale
466			466	sand-oil
474			474	shale
523			474	shale

Operator Reese Exploration, Inc.

Well No. 20-81

Lease Name _____

S 27 T 24 R 22 E ~~MX~~

WELL LOG

Show all important zones of porosity and contents thereof; cored intervals, and all drill-stem tests, including depth interval tested, cushion used, time tool open, flowing and shut-in pressures, and recoveries.

SHOW GEOLOGICAL MARKERS, LOGS RUN, OR OTHER DESCRIPTIVE INFORMATION.

DESIGNATE TYPE OF COMP.: OIL, GAS, DRY HOLE, SWDW, ETC.: OIL