

State Geological Survey


KANSAS DRILLERS LOG WICHITA, BRANCH

S. 34 T. 24 R. 22 E
W

Loc. SW SW SE

County Bourbon

640 Acres
N

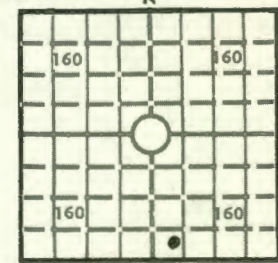

Locate well correctly

Elev.: Gr. 925

DF _____ KB _____

API No. 15 — 011 — 20,197
County Number

Operator
Gator Oil Company

Address
Box 1628 Lake Worth, Florida 33460

Well No. #1 Lease Name Holeman

Footage Location
500 feet from (S) line 500 feet from (W) line

Principal Contractor Nance Drilling Co. Geologist Jay Robertson

Spud Date 9/28/75 Total Depth 679 P.B.T.D.

Date Completed 9/29/75 Oil Purchaser

CASING RECORD

Report of all strings set — surface, intermediate, production, etc.

Purpose of string	Size hole drilled	Size casing set (in O.D.)	Weight lbs./ft.	Setting depth	Type cement	Sacks	Type and percent additives
Overburden	9"	7"	24	22			

LINER RECORD

PERFORATION RECORD

Top, ft.	Bottom, ft.	Sacks cement	Shots per ft.	Size & type	Depth interval

TUBING RECORD

Size	Setting depth	Packer set at			

ACID, FRACTURE, SHOT, CEMENT SQUEEZE RECORD

Amount and kind of material used	Depth interval treated

INITIAL PRODUCTION

Date of first production _____ Producing method (flowing, pumping, gas lift, etc.) _____

RATE OF PRODUCTION PER 24 HOURS	Oil	Gas	Water	Gas-oil ratio
	bbis.	MCF	bbis.	CFPB

Disposition of gas (vented, used on lease or sold) _____ Producing interval (s) _____

INSTRUCTIONS: As provided in KCC Rule 82-2-125, within 90 days after completion of a well, one completed copy of this Drillers Log shall be transmitted to the State Geological Survey of Kansas, 4150 Monroe Street, Wichita, Kansas 67209. Copies of this form are available from the Conservation Division, State Corporation Commission, 3830 So. Meridian (P.O. Box 17027), Wichita, Kansas 66217. Phone AC 316-522-2206. If confidential custody is desired, please note Rule 82-2-125. Drillers Logs will be on open file in the Oil and Gas Division, State Geological Survey of Kansas, Lawrence, Kansas 66044.

Operator **Gator Oil Company** DESIGNATE TYPE OF COMP.: OIL, GAS, DRY HOLE, SWDW, ETC.: **Gas**

Well No. **1** Lease Name **Holeman**

S 34 T 24 R 22 E


WELL LOG

Show all important zones of porosity and contents thereof; cored intervals, and all drill-stem tests, including depth interval tested, cushion used, time tool open, flowing and shut-in pressures, and recoveries.

SHOW GEOLOGICAL MARKERS, LOGS RUN, OR OTHER DESCRIPTIVE INFORMATION.

FORMATION DESCRIPTION, CONTENTS, ETC.	TOP	BOTTOM	NAME	DEPTH
Overburden	0	11		
Red Clay	11	17		
Grey Shale	17	70		
Red Clay & Grey Shale	70	90		
Grey Shale	90	100		
Brown Lime	100	110		
Grey Shale	110	120		
Grey Shale	120	130		
Grey Shale	130	200		
Brown Lime	200	215		
Grey Shale	215	220		
Black Shale	220	250		
Green Lime	250	280		
Grey Shale	280	310		
Grey Shale	310	330		
Dark Grey Shale	330	350		
Grey Shale	350	360		
Black Shale	360	365		
Grey Shale	365	385		
Black Shale	385	390		
Grey Shale	390	465		
Grey Lime	465	470		
Grey Shale	470	495		
Brown Lime	495	500		
Grey Shale	500	669		
		669	Top of Miss.	
Grey Lime	669	679		
		679	T.D.	

USE ADDITIONAL SHEETS, IF NECESSARY, TO COMPLETE WELL RECORD.

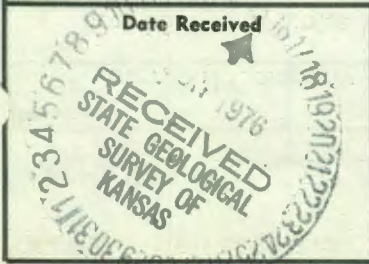

Spud A. Halter
 Signature
 Vice President
 Title
 10-29-75
 Date

926476