


Farm Totland No. 1


By J. B. Griexes

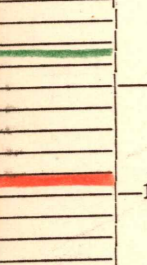

Date.....

Sec. 22 Tp. 24 Range 9
1247

001171

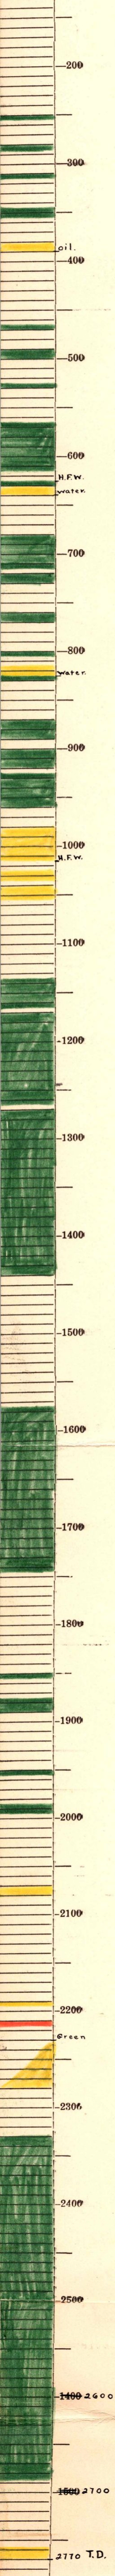

100

200

300

400

500

600

700

800

900

1000

1100

1200

1300

1400

1500

1600

1700

1800

1900

2000

2100

2200

2300

2400

2500

1400 2600

1500 2700

2770 T.D.

1600