


Greenwood
County
Tno Edwards
Farm
Lancaster Et al
Company

No. 1

10
24
27

Range
Township
Section

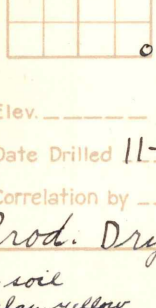

Twp.					
6	5	4	3	2	1
7	8	9	10	11	12
18	17	16	15	14	13
19	20	21	22	23	24
30	29	28	X 26	25	
31	32	33	34	35	36

Elev. _____ T.D. 2835'

Date Drilled 11-21-21

Correlation by
Prod. Dry

