

Map No. _____ Sec. 27 Twp. 24 R. 17
 Well No. 2-Gas-Linn Farm _____
Speka Oil Co. Company

NORTH

WEST

EAST

SOUTH

Location _____
 Drilling Remarks _____

Rig Up _____
 Drilling Remarks _____

RECORD

Cased _____ in. _____ ft.
 Sand _____
 Gas _____
 Oil _____
 Total Depth _____

PRODUCTION

1st 24 hrs. Nat. _____
 1st 24 hrs. after shot _____
 Gas _____ cu. ft.
 Dry Hole _____
 Abandoned _____

Map No. _____ Sec. 27 Twp. 24 R. 17

Well No. 2 - Geo. Lison Farm


Topoka Oil Co Company
NORTH

-----Ft. from N. Line

200 Ft. from S. Line

660 Ft. from E. Line

Ft. from W. Line

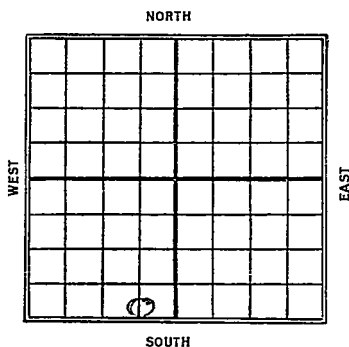

1927

Date _____

REPORT

12/21	1186-1210	TD-1210
	20. hhl	

Woodson
 Map No. *27* Sec. *27* Twp. *24* R. *17*
 Well No. *2 Geo Linn*
Tapeley Oil Co Company

FIRST REPORTS

COMPLETED

Ft. from N. Line

200 Ft. from S. Line*660* Ft. from E. Line

Ft. from W. Line

SECTION PLAT

RECORD

Location

Rig up

Drilling and Remarks:

20 Bls.

Cased _____ in., _____ ft.

Sand *1186-1710*

Gas _____

Oil _____

Total Depth *1710*

PRODUCTION

1st 24 hrs. Nat. _____

1st 24 hrs. after shot _____

Gas _____ Cu. Ft.

Dry Hole _____

Abandoned _____

Date

DEC 21 1927

192 CHAS. L. SHERWOOD

Scout