


11
24 S
31

Greenwood.
County
Wagner No. 1
Farm
Peerless Oil & Ref.
Company

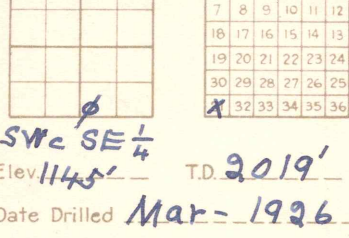

SWc SE $\frac{1}{4}$
Elev 1145' T.D. 2019'
Date Drilled Mar-1926
Correlation by
Prod-Dry



12 1/2" - 740'

wtr.

wtr.

"

10" - 975'

wtr.

1260
175
1185

8 1/4" - 1480'

wtr.

6 5/8" - 2000'

M

Miss-wtr.

T. D. - 2019'