
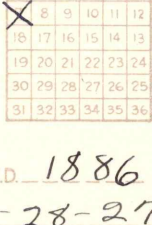


Range  
 Township  
 Section

Greenwood  
 County  
 Gaffney  
 Henderson & Holden  
 Company

No. 1

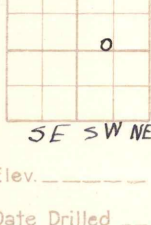


SE SW NE

Elev. \_\_\_\_\_ T.D. 1886

Date Drilled 2-28-27

Correlation by \_\_\_\_\_

1P - 10 bbls

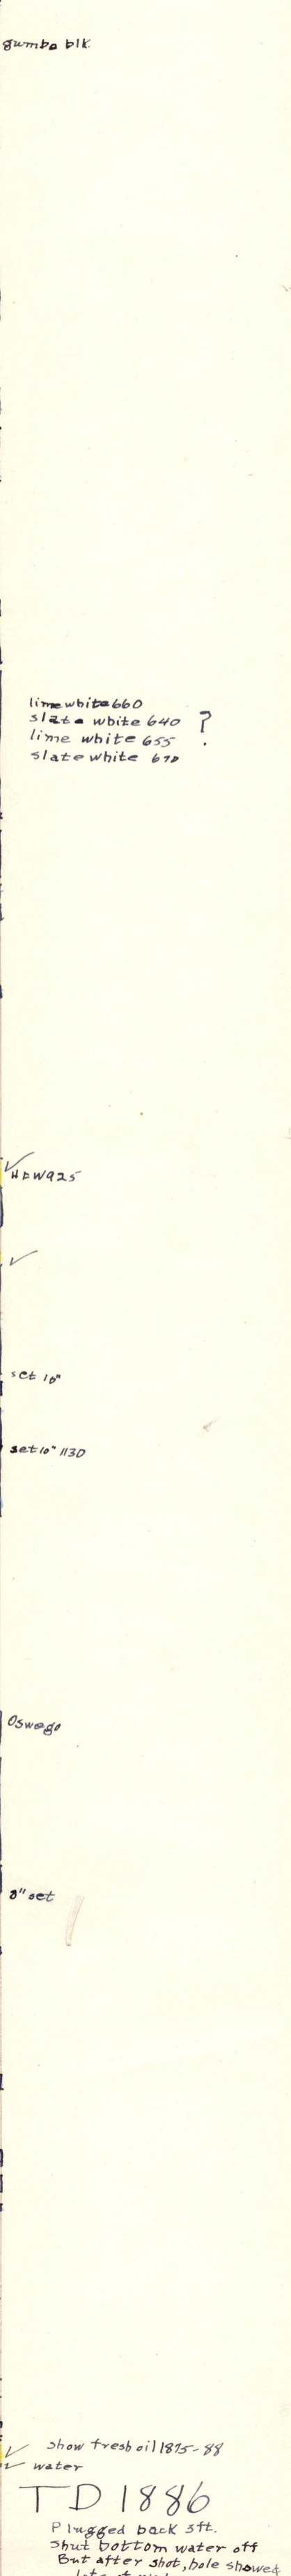

TD 1886  
 Plugged back 3ft.  
 Shut bottom water off  
 But after shot, hole showed  
 lots of water  
 Swabbed 24 bbls. on 24hr.  
 test.