

Sec. 26 Twp. 24 Rge. 9E


Owner J. L. ... et al

Farm ... Well No. 4

Contract ...

Compass. N. S 132° W 660
E. NORTH

- Case used _____
- 15 1/2 _____ ft.
- 12 1/2 _____ ft.
- 10 _____ ft.
- 8 1/2 _____ ft.
- 6 _____ ft.
- 5 9/16 _____ ft.

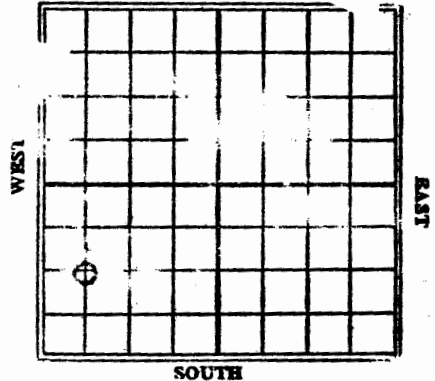

Location _____

Rig _____

Drilling at _____ ft. Fishing at _____ ft.

Total Depth 27 Completed

1st 24 Hrs. Nat. _____ Producing _____

1st 24 Hrs. Shot _____ Dry Hole

Gas _____ Cu. ft. Abandoned _____

Sands—give name and depth. Top 210 Bottom 2155

Broken sand, show oil
Completed

TL 2295

Well log 2733-2752

#1-2-3 in Sec 27

Date of Report JUN 2 1926

Reported by J. H. SALADIN