

Kansas

Map No. _____ Sec. 31 Twp. 25 R. 11EWell No. 3 Smith-Cadallie


Broadbeck & Bethel

Company

Contractor

C E/2 NE NE

SECTION PLAT

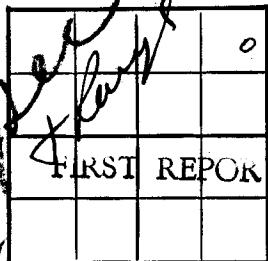660 Ft. from N. Line

Ft. from S. Line

75 Ft. from E. Line

Ft. from W. Line

Greenwood

Location

RECORD

Cased _____ in., _____ ft.

Rig up

Sand _____

Drilling and Remarks:

Gas _____

Oil _____

Spud 6-5-50

Total Depth _____

8" @ 80

W. O. C.

PRODUCTION

1st 24 hrs. Nat. _____

1st 24 hrs. after shot _____

Gas _____ Cu. Ft.

Dry Hole _____

Abandoned _____

Date

JUN 7 1950

19

J. E. TYRA

Scout

Kansas

Map No. _____ Sec. 36 Twp. 25 R. 10EWell No. 3 Smith-Cadallie


Broadbeck & Bethel

Company

Contractor

C E L NE NE

SECTION PLAT

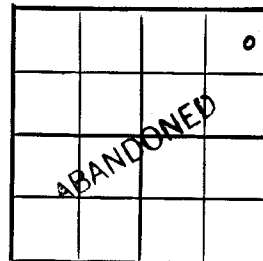

Ft. from N. Line

660 Ft. from S. Line

Ft. from E. Line

75 Ft. from W. Line

Greenwood County

Location

RECORD

Cased _____ in., _____ ft.

Rig up

Sand _____

Drilling and Remarks:

Gas _____

Oil _____

8" @ 80

Total Depth 2067

Miss. 2027

PRODUCTION

5" @ 2032

1st 24 hrs. Nat. _____

TD 2067

1st 24 hrs. after shot _____

D & A

Gas _____ Cu. Ft.

Dry Hole _____

Abandoned _____

Date

JUL 5 1950


19

J. E. TYRA

Scout

Sec. 31 36 Twp. 25 R. 11-E
Well No. #3 Smith-Cadallie Farm
Broadbeck & Bethel Company
Contractor

660 Ft. from N. Line
Ft. from S. Line
75 Ft. from E. Line
Ft. from W. Line
C E/2 NE NE

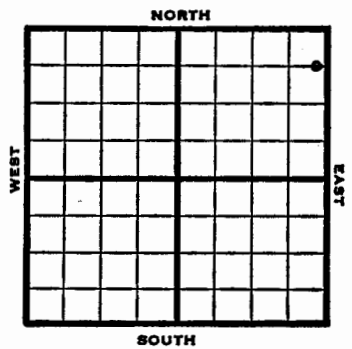

1950 Elev. ? REPORT

6/7 Spud 6-5-50
8" @ 80
W.O.C.
7/5 8" @ 80'
Miss 2027'
5" @ 2032'
TD 2067'
D&A
ABANDONED

Well No. #3 Smith-Cadallie
Company Broadbeck & Bethel

