

KANSAS

WELL COMPLETION REPORT AND
DRILLER'S LOG

State Geological Survey

WICHITA BRANCH

API No. 15 — Allen — 001-23-866
County Number

Operator

Buford Lanson

Address

Eismore Kansas

Well No.

1

Lease Name

Lanson Farm

Footage Location

2510 feet from (N) line 2480 feet from (W) line

Principal Contractor

Dorwin Jackson

Geologist

Spud Date

Date Completed

3-1-81

Total Depth

775

P.B.T.D.


706

Directional Deviation

Oil and Gas Purchaser

S. 32 T. 25 R. 21 E NW 4 W

Loc.

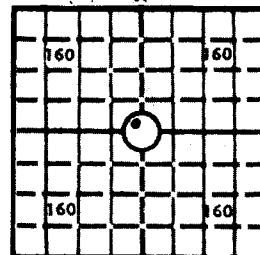County Allen640 Acres
N

Locate well correctly

Elev.: Gr.

DF

KB

CASING RECORD

Report of oil strings set — surface, intermediate, production, etc.

Purpose of string	Size hole drilled	Size casing set (in O.D.)	Weight lbs./ft.	Setting depth	Type cement	Sacks	Type and percent additives
	<u>5 7/8</u>	<u>6 5/8</u>		<u>775</u>			<u>gel</u>

LINER RECORD

PERFORATION RECORD

Top, ft.	Bottom, ft.	Sacks cement	Shots per ft.	Size & type	Depth interval
<u>Cement</u>	<u>top to bottom</u>	<u>100</u>			
TUBING RECORD			<u>2 in ft</u>	<u>Glass Jet</u>	<u>680-689</u>
Size	Setting depth	Production			
<u>2 1/2</u>	<u>706</u>				

ACID, FRACTURE, SHOT, CEMENT SQUEEZE RECORD

Amount and kind of material used	Depth interval treated
<u>acid 15 gals - Fracture with 2800# sand</u>	

INITIAL PRODUCTION

Date of first production <u>3-1-81</u>	Producing method (flowing, pumping, gas lift, etc.)
RATE OF PRODUCTION PER 24 HOURS	Oil <u>2</u> bbls. Gas MCF Water bbls. Gas-oil ratio CFPB
Disposition of gas (vented, used on lease or sold)	Producing interval (s)

INSTRUCTIONS: As provided in KCC Rule 82-2-125, within 90 days after completion of a well, one completed copy of this Drillers Log shall be transmitted to the State Geological Survey of Kansas, 4150 Monroe Street, Wichita, Kansas 67209. Copies of this form are available from the Conservation Division, State Corporation Commission, 245 No. Water, Wichita, Kansas 67202. Phone AC 316-522-2206. If confidential custody is desired, please note Rule 82-2-125. Drillers Logs will be on open file in the Oil and Gas Division, State Geological Survey of Kansas, Lawrence, Kansas 66044.

Operator

DESIGNATE TYPE OF COMP.: OIL, GAS,
DRY HOLE, SWDW, ETC.:

Well No.

Lease Name

S _____ T _____ R _____ E _____
W _____

WELL LOG

Show all important zones of porosity and contents thereof; cored intervals, and all drill-stem tests, including depth interval tested, cushion used, time tool open, flowing and shut-in pressures, and recoveries.

SHOW GEOLOGICAL MARKERS, LOGS RUN,
OR OTHER DESCRIPTIVE INFORMATION.

FORMATION DESCRIPTION, CONTENTS, ETC.

TOP

BOTTOM

NAME

DEPTH

USE ADDITIONAL SHEETS, IF NECESSARY, TO COMPLETE WELL RECORD.

Date Received

Burford Larson


Signature

Owner & Operator

Title

12-10-81

Date

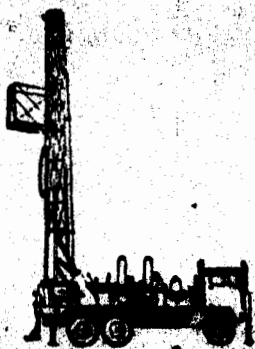

State Geological Survey
WICHITA BRANCH
Dorwin Jackson

OIL & WATER — WELL DRILLING — 2-ROTARY RIGS
P. O. Box 104 Phone (316) 939-4900
BRONSON, KANSAS 66716

APL#15-001-23-856

COMPANY Larson Farms Inc.

FARM Buford Larson

WELL NO. 1

SEC. 32 TWP. 25. RGE. 21 LOC.

COUNTY Allen

STATE Kansas

CONTRACTOR Dorwin Jackson

SIZE HOLE 5 1/8"

DRILL PIPE 20' Ave

REMARKS: Set & Cemented 20' of Surface Pipe. SIZE PUMP LINERS

LENGTH STROKE

Set Seating Nipple at 679.5'.
Set 700.5' of 25" casing.

DATE January 29, 1981

DEPTH	TIME O'CLOCK	MIN.	REMARKS
0	1		Topsoil
2	3		Clay
1	4		Clay & Loose Rock
50	50		Lime
3	53		Shale
1	54		Lime
2	56		Shale
12	78		Sandy Shale
58	126		Lime
5	141		Shale
1	142		Lime
4	146		Shale
21	167		Lime
101	268		Shale
3	270		Lime & Sand
17	290		Sandy Shale
12	302		Limey-Shale
1	303		Lime
1	303		Limey-Shale
8	316		Lime
2	318		Shale
12	330		Limey-Shale(Broken)
5	335		Shale
2	337		Sandy-Dry
2	339		Lime
2	347		Sandy-Shale
2	349		Sandy-Dry
39	381		Shale
40	428		Lime
42	470		Shale
19	489		Lime
6	495		Shale
5	500		Lime
4	504		Shale
2	506		Sandy Shale
2	508		Limey
39	597		Shale

[illegible]