

GEOLOGICAL DEPARTMENT
UNION GAS CORPORATION
INDEPENDENCE, KANSAS

8-25-24E

Company Southwestern Gas Company

S. T. R. 8-25-24
County Bourbon
State Kansas
Lease and Geo. M. Stauffer
Well No. #1

Contractor Union Gas Corporation


Drilling Commenced Aug. 11, 1928 Drilling Completed Aug. 16, 1928

Initial Production Dry. Plugged

Initial Rock Pressure

Location 1010' E. and 1040' N. of SW corner of NW 1/4.

Casing

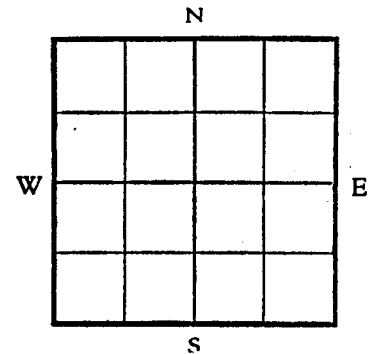

Driller's Record of Formations

80	soil	5
2	clay	5
6	lime	11
2	shale	13
8	lime	21
9	shale black	30
15	shale light	45
10	shale dark	55
12	shale light	67
18	lime	85
6	shale black	91 gas tested 7/10" in 1 in.
5	lime	96
6	shale dark	102 hole red. at 97'
63	shale light	165
15	shale dark	180
20	shale light	200
1	lime	201
2	shale dark	203
1	lime	204
31	shale light	235
15	shale dark	250
15	shale dark	265
10	shale light	275
5	shale sandy	289
15	shale light	295
20	shale dark	315
5	lime sandy	320
10	shale light	330
10	shale dark	340
5	shale light	345
9	shale light	354
17	shale dark	371 S.L.M. 371
22	sand	393 oil heavy
13	shale light	406
42	shale dark	448 S.L.M. 448
25	Mississippi lime	473 water at 470-473