

12-25-4E

Company E. H. ADAIR

Farm Eaton

No. 3

(AKA. EATON A-3)

SEC. 22

T. 25

R. 4 E

NE NW SE

Total Depth. 2624'

Comm. 8-21-46

Comp. 9-14-46

Shot or treated.


Contractor.

issued 9-28-46

County.

Butler

KANSAS

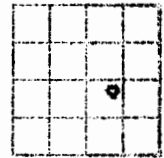

CASINGS:

15 1/2" 155' 8 1/4" 2320'
13 3/8" 915' 6 5/8" 2598'
10" 1690'

Elevation. _____

Production. Est. 50 B.

Figures indicate Bottom of Formations.

cellar	8	shale	1210
clay	40	lime	1225
shale	55	shale	1230
gravel	65	lime	1260
shale	70	shale	1275
red rock	85	lime	1310
lime	90	shale	1315
shale	95	lime	1365
lime	125	shale	1370
shale	145	lime	1495
lime	150	shale	1530
shale	165	lime	1580
lime	185	shale	1585
sandy lime	215	lime	1600
shale	230	shale	1615
lime	235	lime	1630
shale	250	shale	1645
red rock	255	lime	1655
lime	275	shale sdy	1665
shale	290	shale	1750
lime	300	lime	1755
red rock	305	shale	1785
lime	325	lime	1800
shale	355	shale	1845
shale & shells	415	lime	1985
shale	425	shale	2010
lime	435	shale sdy	2106
shale & shells	460	2030=56' Corr.	
lime	475	shale	2150
shale & shells	530	lime	2285
lime	550	shale	2290
shale	560	lime	2315
lime	570	shale	2385
shale & shells	710	lime	2400
red rock	715	shale	2410
lime	725	lime	2445
shale	730	shale	2475
lime	735	lime	2485
shale	755	shale	2500
lime	760	lime	2515
shale & shells	790	shale	2520
sand	800	lime	2530
shale	815	shale	2545
shale & shells	910	lime	2550
lime	995	shale	2575
shale	1010	lime	2579
lime	1015	shale green	2581
shale	1025	lime	2584
lime	1030	shale	2592
shale	1100	lime	2598
lime	1140	conglomerate	2610
shale	1145	chat	2624
lime	1155	Total Depth.	
shale	1160		
lime	1170		
shale	1175		
shale sdy	1190		
lime	1200		

Company E. H. Alair et al No. *3 "A" Farm, Eaton
Elev. 1378 rh Location NE 1/4 SE S. 22 T. 25 S.R. 42 E

County.....Butler.....	FR 3-21-46	Log Data	Rh 10-1-46
IP 35 BO & 10% WPI	RU Std	Farm #3	T Lans 1845
T.D. 2624		TD 2624	T K.C. 2150
Comm. 8-21-46	Comp 9-25-46	T Cg 2598	T Miss 2610
Comp. 9-14-46	TL 1845		TD 2624
P.B.....	T Kc 2150		Prod Zone Miss
Pool. El Dorado	6" 2598		
	TML 2610		

Shows

Water	Oil	Gas
-------	-----	-----


[illegible]

1	2	3
---	---	---

.....		
-------	-------	-------

[illegible]

Kansas Pool Name MiscellaneousMap No. 14 Kansas Sec. 22 Twp. 25 R. 4EWell No. 3 Eaton "A"

Ed Adair Company

FIRST REPORT Contractor


NE NW SE

SECTION PLAT

330 Ft. from N. Line

Ft. from S. Line

Ft. from E. Line

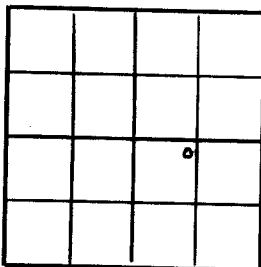990 Ft. from W. Line

Butler County

Location

Rig up

Drilling and Remarks:

Machine

RECORD

Cased in, ft.

Sand

Gas

Oil

Total Depth

PRODUCTION

1st 24 hrs. Nat.

1st 24 hrs. after shot

Gas Cu. Ft.

Dry Hole

Abandoned

Date

AUG 21 1946 19

S. J. LEWIS

Scout

KANSAS Kansas Pool Name MiscellaneousMap No. 14 Sec. 22 Twp. 25 R. 4EWell No. 3 Eaton "A"

Ed Adair Company

COMPLETED Contractor


NE NW SE

SECTION PLAT

330 Ft. from N. Line

Ft. from S. Line

Ft. from E. Line

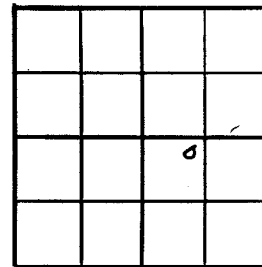990 Ft. from W. Line

Butler County

Location

Rig up

Drilling and Remarks:

*Misc 2610**6" Cased**Pump 350 ft**16 1/2 W Port**72" in*

RECORD

Cased in, ft.

Sand

Gas

Oil

Total Depth 2624

PRODUCTION

1st 24 hrs. Nat.

1st 24 hrs. after shot

Gas Cu. Ft.

Dry Hole

Abandoned

Date

SEP 25 1946 19

S. J. LEWIS Scout

KANSAS

Butler County ✓

Sec. 22 Twp. 25 R. 4EWell No. #3 Eaton "A" Farm _____

Ed Adair

Company _____

Miscellaneous

330

Ft. from N. Line


Ft. from S. Line

Ft. from E. Line

990

Ft. from W. Line

NE NW SE

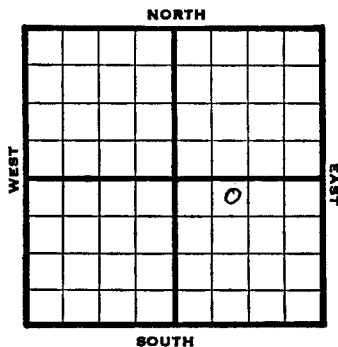

1946 Elev. 1378' REPORT

8/21 Machine

8/27 15" @ 155

Drlg 670'

9/5 13" @ 925'

1690 Run 10"

9/10 Lans 1845'

KC 2150

8" @ 2320'

Drlg 2420'

9/18 Miss 2610

6" @ 2592'

TD 2624-1710' oil

9/25 Miss 2610'

6" @ 2592'

TD 2624'

Pump 35-oil plus 10% W POT

Grav 40

COMPLETED