

Sec. 7 Twp. 25 R. 5E

Well No. 6 Pierpont Farm

Ralph Wixson Company
Butler County

 Ft. from N. Line


330 Ft. from S. Line

990 Ft. from E. Line

 Ft. from W. Line

SW SE SW

Elev. Esy. 1420' SOUTH

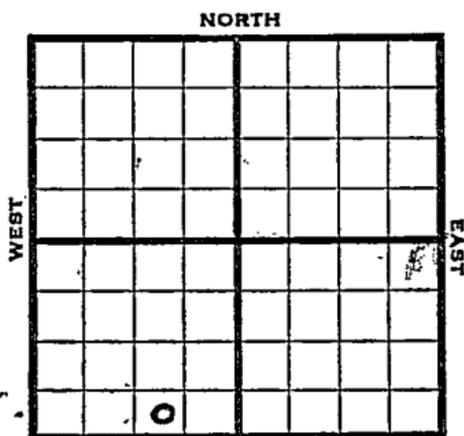

REPORT

1947

3/26 Location

4/2 Mach.

4/9 Drlg. 100'

4/15 15" @ 200'
12" @ 920'
Drlg. 930'

4/23 10" @ 1700' CO

4/29 Lens 1845
KC 2130
8" @ 2232
Drlg 2350'

5/7 Mississippi 2574'
7" @ 2577'
TD 2625'
110 qts. 2589-2625'
CO

5/13 TD 2665'

5/21 Miss 2574
7" @ 2577'
Pump 20 Pot
Grav. 38
TD 2665'

COMPLETED

Map No. K14 Sec. 7 Twp. 25 R. 5E

Well No. 6 Pierpont

Ralph Wixson Company

FIRST REPORT

Contractor

SW SE SW

SECTION PLAT

_____ Ft. from N. Line

330 Ft. from S. Line

990 Ft. from E. Line

_____ Ft. from W. Line

Butler County

Location X

Rig up _____

Drilling and Remarks:

RECORD

Cased _____ in., _____ ft.

Sand _____

Gas _____

Oil _____

Total Depth _____

PRODUCTION

1st 24 hrs. Nat. _____

1st 24 hrs. after shot _____

Gas _____ Cu. Ft.

Dry Hole _____

Abandoned _____

Date

MAR 26 1947 19

S. J. LEWIS Scout

